

MONUMENT 313

CERTIFICATE OF LOCATION OF GOVERNMENT CORNER

Northeast Corner of Section 1, Township 29 North, Range 23 West, County of Ramsey, State of Minnesota.


At the corner location shown on the sketch

On June 21, 2006 found a cast iron monument, flush. Monument is located under Rice Street bridge.

left monument as found lowered monument removed monument (explain)

On _____ placed a _____

SKETCH OF REFERENCE TIES

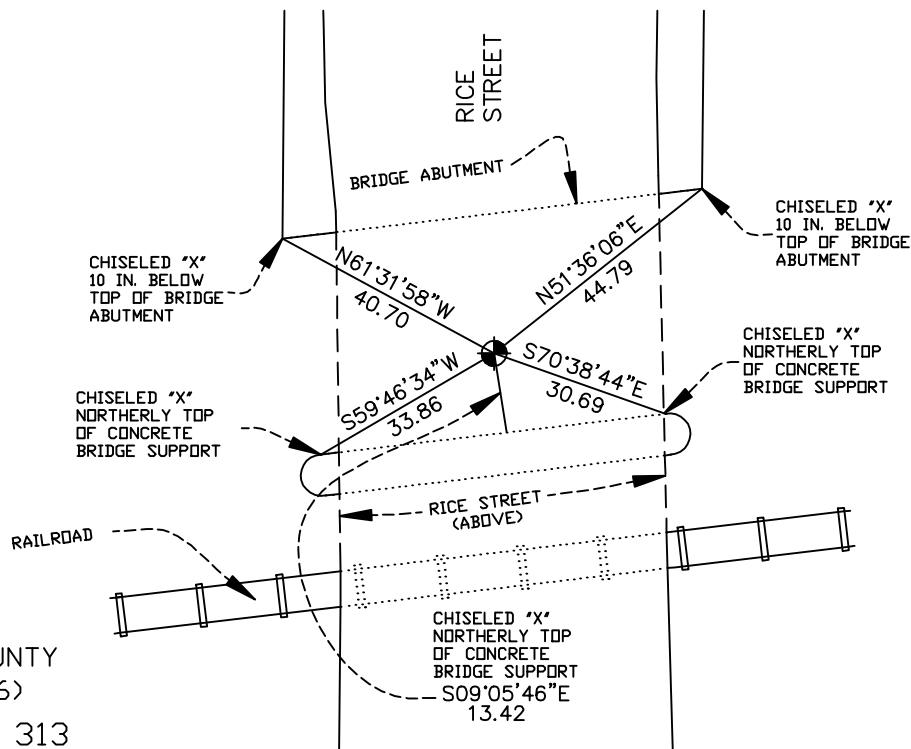

RAMSEY COUNTY
NAD83 (1986)
MONUMENT 313

X= 571644.336 (Easting)
Y= 189373.523 (Northing)

ALL DISTANCES ARE SHOWN IN U.S. SURVEY FEET.
BEARINGS ARE FOR TIE REFERENCE PURPOSES ONLY.

Statements of evidence relative to this corner are on the following page(s).

I hereby certify that this document and the data contained herein was prepared by me or under my direct supervision this _____ day of _____, 20____.

SIGNATURE

Minnesota License No. _____

County Surveyor Land Surveyor

OFFICE OF COUNTY SURVEYOR

County of Ramsey

I hereby certify that this document was filed in the County Surveyor's office on the ____ day of _____, 20____.

David D. Claypool, P.L.S., County Surveyor

By _____, Deputy

MONUMENT 313

Found railroad spike, possibly not the correct corner, July, 1974.

Determined coordinate location of monument by locating irons in adjoining plats done by Ray Wolfgram. Bridge deck removed, Minnesota Department of Transportation, (John Sutherland) and I dug for monument, found nothing, May 1, 1987.

Traversed under new bridge and placed 20 in. cast iron monument, that is positioned according to information on adjoining plats to the northwest and southwest done by Ray Wolfgram. Placed sign and post and retied monument, August 7, 1989.

Retied monument, June 21, 2006.