

# MONUMENT 395

## CERTIFICATE OF LOCATION OF GOVERNMENT CORNER

Northwest Corner of Section 17, Township 29 North, Range 23 West, County of Ramsey, State of Minnesota.


At the corner location shown on the sketch

On July 10, 2006 found a Hennepin County cast iron monument. Monument located under Interstate Highway No. 35W.

left monument as found     lowered monument     removed monument (explain)

On \_\_\_\_\_ placed a \_\_\_\_\_

### SKETCH OF REFERENCE TIES

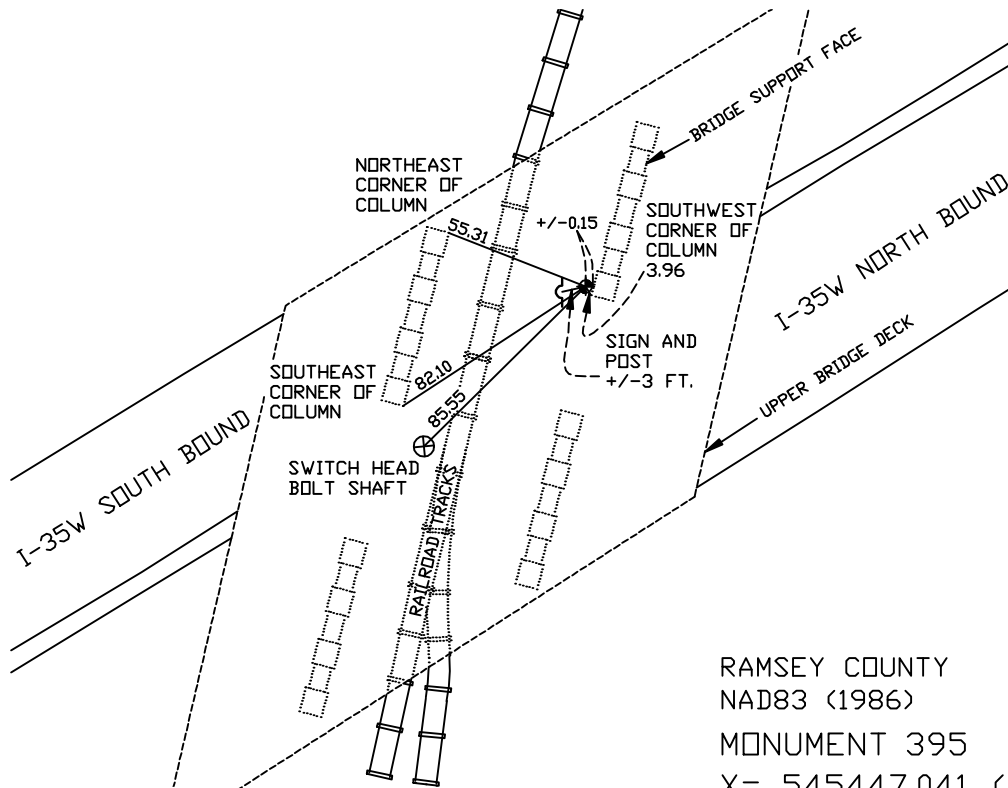

RAMSEY COUNTY  
 NAD83 (1986)  
 MONUMENT 395  
 X= 545447.041 (Easting)  
 Y= 178447.692 (Northing)

ALL DISTANCES ARE SHOWN IN U.S. SURVEY FEET.

Statements of evidence relative to this corner are on the following page(s).

I hereby certify that this document and the data contained herein was prepared by me or under my direct supervision this \_\_\_\_\_ day of \_\_\_\_\_, 20\_\_\_\_.

SIGNATURE

Minnesota License No. \_\_\_\_\_

County Surveyor     Land Surveyor

OFFICE OF COUNTY SURVEYOR

County of Ramsey

I hereby certify that this document was filed in the County Surveyor's office on the \_\_\_\_ day of \_\_\_\_\_, 20\_\_\_\_.

David D. Claypool, P.L.S., County Surveyor

By \_\_\_\_\_, Deputy

## MONUMENT 395

**Found a cast iron monument under bridge on east slope, 1975.**

**Checked monument, August 29, 1977.**

**Retied monument, August 16, 1984.**

**Placed sign and post and retied monument, August 13, 1990.**

**Retied monument, July 10, 2006.**