

MONUMENT 403N

CERTIFICATE OF LOCATION OF GOVERNMENT CORNER

North Witness Corner to the Northeast Corner of Section 14, Township 29 North, Range 23 West, County of Ramsey, State of Minnesota.


At the corner location shown on the sketch

On August 8, 2007 found a cast iron monument within a cast iron manhole assembly.

left monument as found lowered monument removed monument (explain)

On _____ placed a _____

SKETCH OF REFERENCE TIES

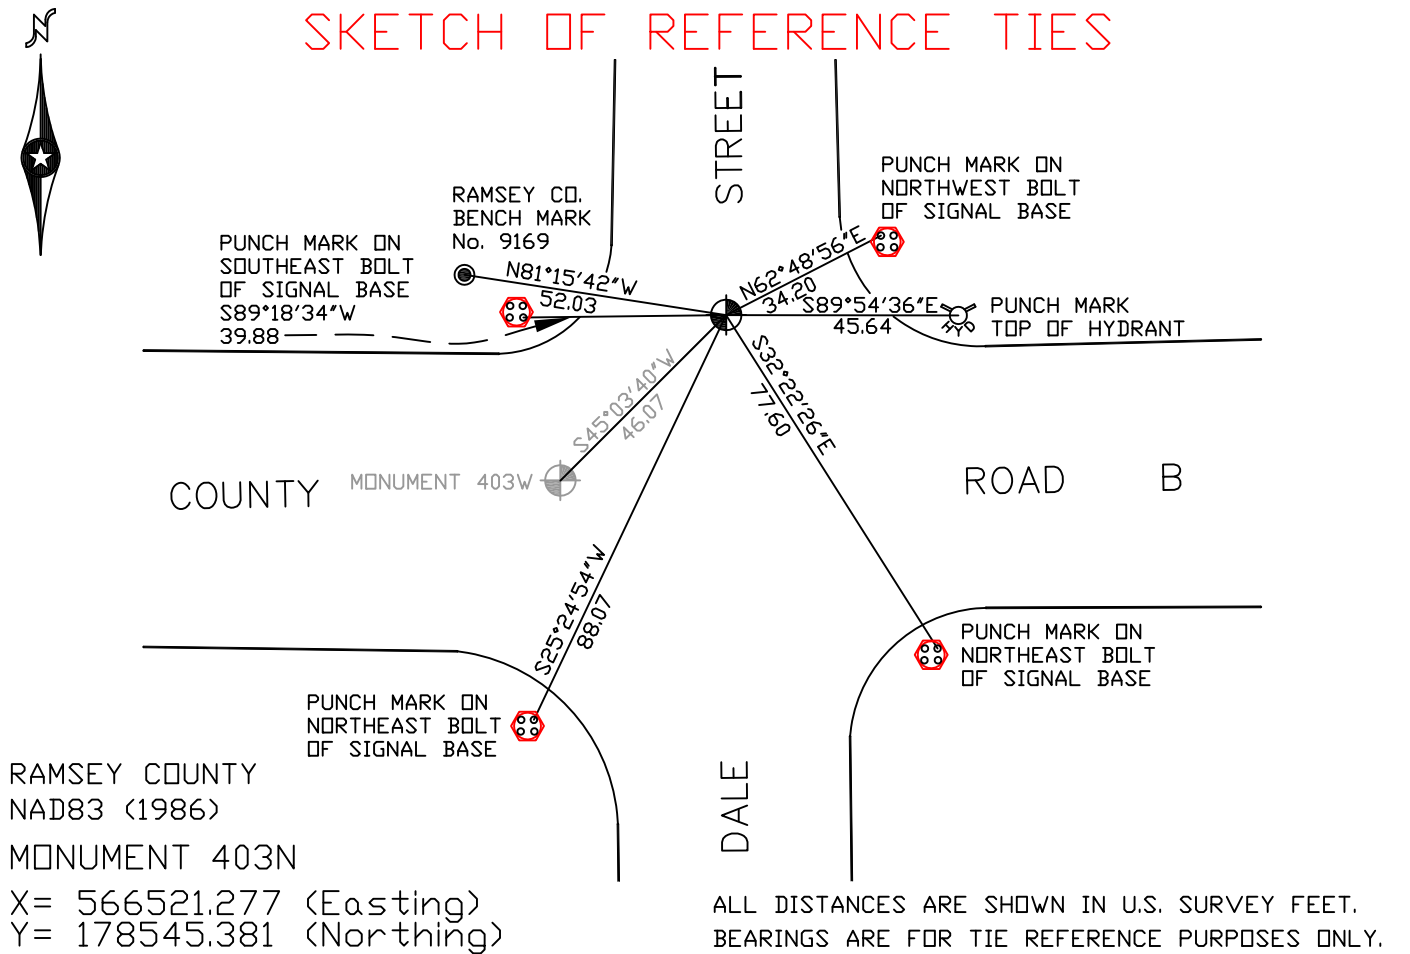

Statements of evidence relative to this corner are on the following page(s).

I hereby certify that this document and the data contained herein was prepared by me or under my direct supervision this _____ day of _____, 20____.

SIGNATURE

Minnesota License No. _____

- County Surveyor
 Deputy County Surveyor Land Surveyor

OFFICE OF COUNTY SURVEYOR

County of Ramsey

I hereby certify that this document was filed in the County Surveyor's office on the ____ day of _____, 20____.

David D. Claypool, P.L.S., County Surveyor

By _____, Deputy

MONUMENT 403N

Found a manhole at monument location; see "Survey Book No. 2" and Sections 11 and 13, T29N, R23W folders. Placed cast iron monument 33 ft. north on line, no date given in field book.

Retied monument, March 26, 1985.

Removed monument and reset cast iron monument 18 in. below street grade; contractor to set tube and cast iron manhole assembly, July 10, 2001.

Retied monument, July 19, 2002.

Retied monument, August 8, 2007.