

# MONUMENT 428

## CERTIFICATE OF LOCATION OF GOVERNMENT CORNER

West Quarter Corner of Section 18, Township 29 North, Range 22 West, County of Ramsey, State of Minnesota.


At the corner location shown on the sketch

On August 22, 2007 found a cast iron monument, flush.

left monument as found     lowered monument     removed monument (explain)

On \_\_\_\_\_ placed a \_\_\_\_\_

### SKETCH OF REFERENCE TIES

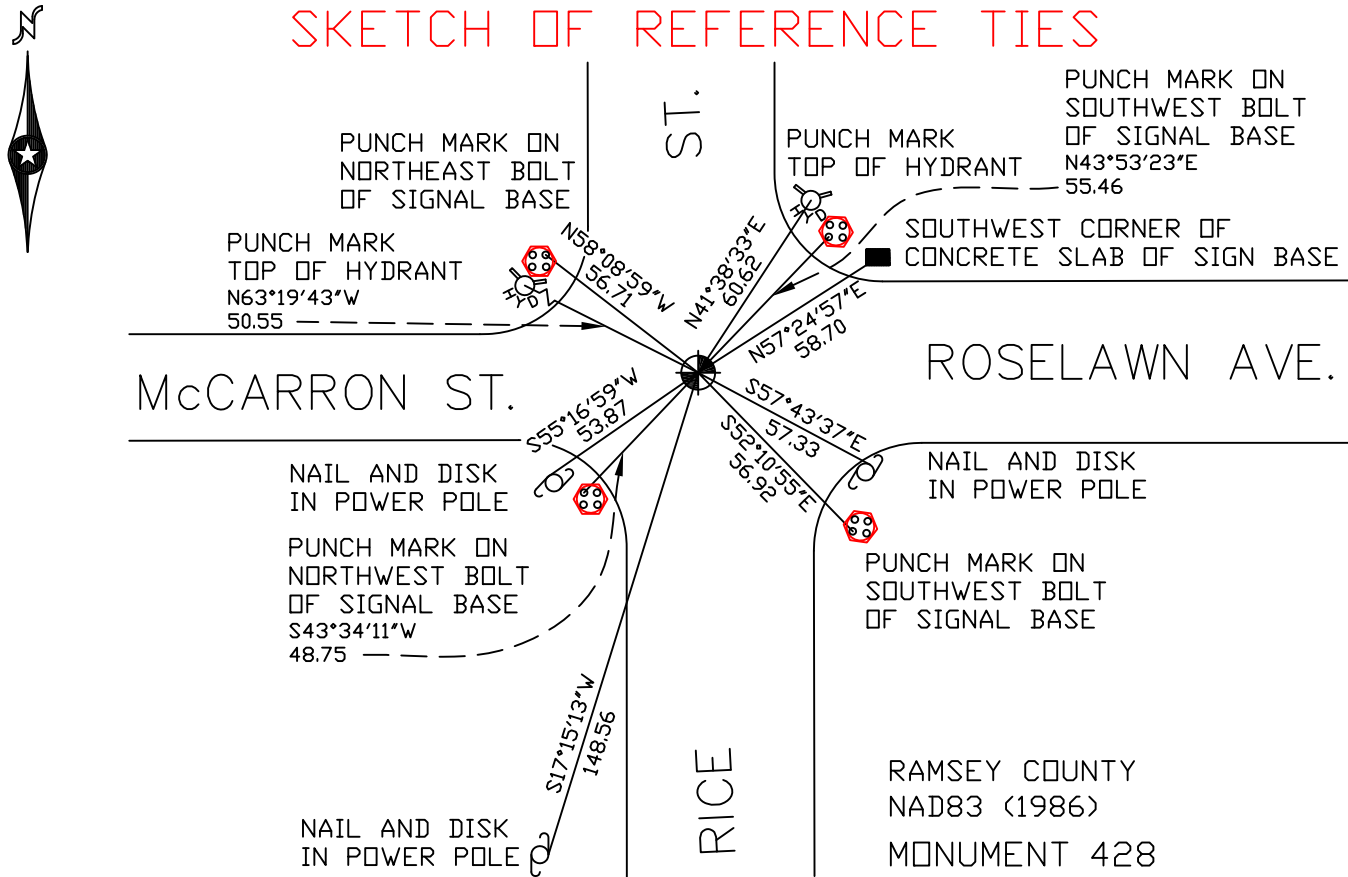

ALL DISTANCES ARE SHOWN IN U.S. SURVEY FEET.  
BEARINGS ARE FOR TIE REFERENCE PURPOSES ONLY.

RAMSEY COUNTY  
NAD83 (1986)  
MONUMENT 428

X = 571775.401 (Easting)  
Y = 175953.604 (Northing)

Statements of evidence relative to this corner are on the following page(s).

I hereby certify that this document and the data contained herein was prepared by me or under my direct supervision this \_\_\_\_\_ day of \_\_\_\_\_, 20\_\_\_\_.

SIGNATURE

Minnesota License No. \_\_\_\_\_

- County Surveyor  
 Deputy County Surveyor     Land Surveyor

OFFICE OF COUNTY SURVEYOR  
County of Ramsey

I hereby certify that this document was filed in the County Surveyor's office on the \_\_\_\_ day of \_\_\_\_\_, 20\_\_\_\_.

David D. Claypool, P.L.S., County Surveyor

By \_\_\_\_\_, Deputy

## MONUMENT 428

Used old ties and dug through the top 2 in. of bituminous and found 3/4 in. diameter brass plug, September 23, 1974.

Set a cast iron cap and bolt monument, June 1, 1976.

Monument checked, July 29, 1977.

Tied monument, July 16, 1990.

Found cast iron monument, down +/- 0.08 ft., after road overlay and storm sewer construction by Mn/DOT, September 29, 1992.

Retied monument, July 19, 2002.

Monument gone, August 7, 2007.

Dug out hole where monument was and found granite monument, down 4 in. Checked ties and the 1/2 mile distance to the Southwest Corner of Section 18, Township 29, Range 22; found some ties the same and distance to the Southwest Corner within 0.03 ft. of computed distance; set a cast iron cap and bolt monument over granite monument, in concrete, flush with road surface, August 16, 2007.

Retied monument, August 22, 2007.