

# MONUMENT 429

## CERTIFICATE OF LOCATION OF GOVERNMENT CORNER

Center of Section 18, Township 29 North, Range 22 West, County of Ramsey,  
State of Minnesota.


At the corner location shown on the sketch

On August 9, 2007 found a cast iron monument, flush.

left monument as found     lowered monument     removed monument (explain)

On \_\_\_\_\_ placed a \_\_\_\_\_

### SKETCH OF REFERENCE TIES

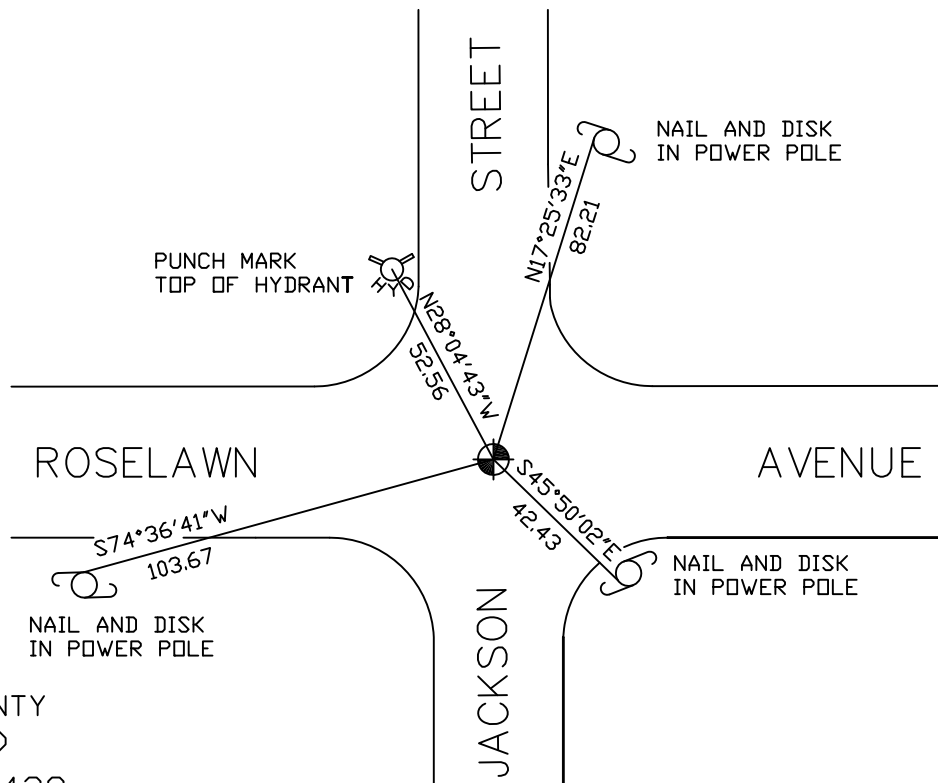

RAMSEY COUNTY  
NAD83 (1986)  
MONUMENT 429

X= 574189.527 (Easting)  
Y= 175954.032 (Northing)

ALL DISTANCES ARE SHOWN IN U.S. SURVEY FEET.  
BEARINGS ARE FOR TIE REFERENCE PURPOSES ONLY.

Statements of evidence relative to this corner are on the following page(s).

I hereby certify that this document and the data contained herein was prepared by me or under my direct supervision this \_\_\_\_\_ day of \_\_\_\_\_, 20\_\_\_\_.

SIGNATURE

Minnesota License No. \_\_\_\_\_

- County Surveyor  
 Deputy County Surveyor     Land Surveyor

OFFICE OF COUNTY SURVEYOR  
County of Ramsey

I hereby certify that this document was filed in the County Surveyor's office on the \_\_\_\_ day of \_\_\_\_\_, 20\_\_\_\_.

David D. Claypool, P.L.S., County Surveyor

By \_\_\_\_\_, Deputy

## MONUMENT 429

Found a cast iron monument down 6 in. and reset to grade, June 1, 1976.

Retied monument, August 17, 1984.

Monument removed for Construction Department; set a P.K. nail for position after construction, September 29, 1992.

Set a 20 in. cast iron monument, October 13, 1992.

Cemented monument in place, October 20, 1993.

Retied monument, July 8, 2002.

Retied monument, August 9, 2007.