

MONUMENT 446

CERTIFICATE OF LOCATION OF GOVERNMENT CORNER

South Quarter Corner of Section 15, Township 29 North, Range 23 West, County of Ramsey, State of Minnesota.


At the corner location shown on the sketch

On September 5, 2007 found a cast iron monument within a cast iron manhole assembly.

left monument as found lowered monument removed monument (explain)

On _____ placed a _____

SKETCH OF REFERENCE TIES

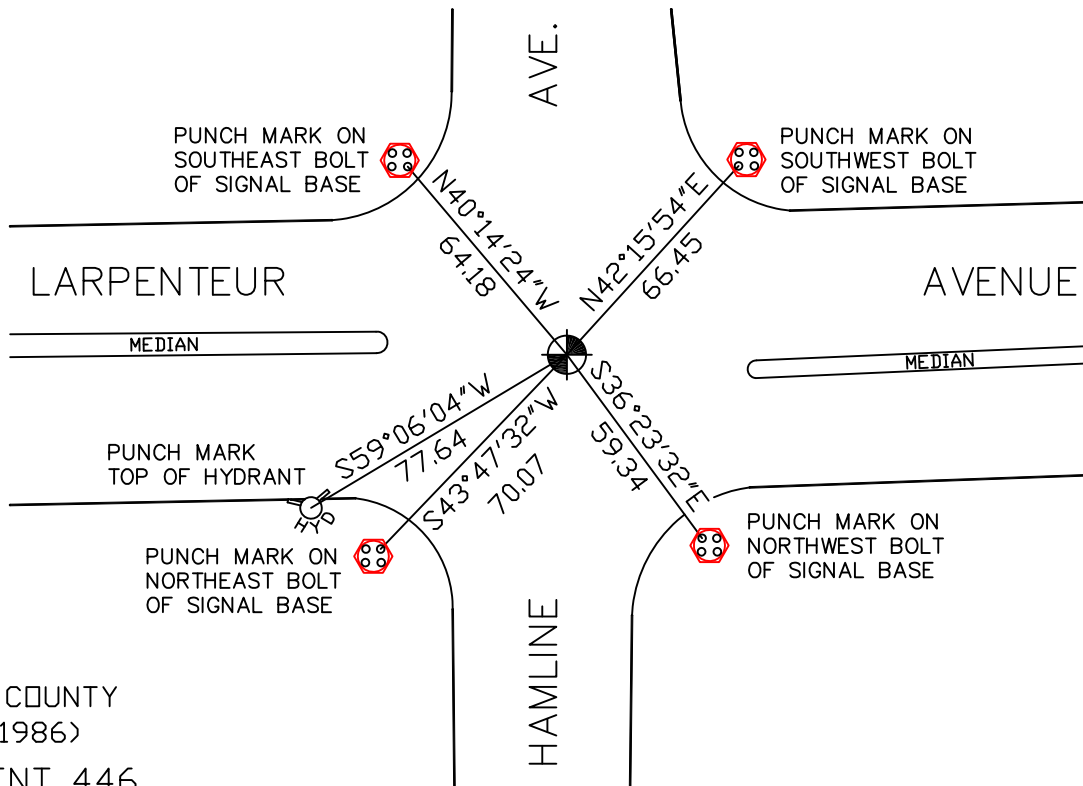

RAMSEY COUNTY
NAD83 (1986)
MONUMENT 446

X= 558674.417 (Easting)
Y= 173270.858 (Northing)

ALL DISTANCES ARE SHOWN IN U.S. SURVEY FEET.
BEARINGS ARE FOR TIE REFERENCE PURPOSES ONLY.

Statements of evidence relative to this corner are on the following page(s).

I hereby certify that this document and the data contained herein was prepared by me or under my direct supervision this _____ day of _____, 20____.

SIGNATURE

Minnesota License No. _____

- County Surveyor
 Deputy County Surveyor Land Surveyor

OFFICE OF COUNTY SURVEYOR
County of Ramsey

I hereby certify that this document was filed in the County Surveyor's office on the ____ day of _____, 20____.

David D. Claypool, P.L.S., County Surveyor

By _____, Deputy

MONUMENT 446

Found a granite monument, June 18, 1976.

Checked monument, August 12, 1977.

Tied out granite monument for removal by construction, April 26, 2000.

Set a 20 in. cast iron monument, down 18 in.; Shafer Contracting to set P.V.C. pipe and cast iron manhole assembly, July, 2000.

Retied monument, March 28, 2001.

Retied monument, September 5, 2007.