

MONUMENT 448

CERTIFICATE OF LOCATION OF GOVERNMENT CORNER

South Quarter Corner of Section 14, Township 29 North, Range 23 West, County of Ramsey, State of Minnesota.


At the corner location shown on the sketch

On September 5, 2007 found a brass plug, flush.

left monument as found lowered monument removed monument (explain)

On _____ placed a _____

SKETCH OF REFERENCE TIES

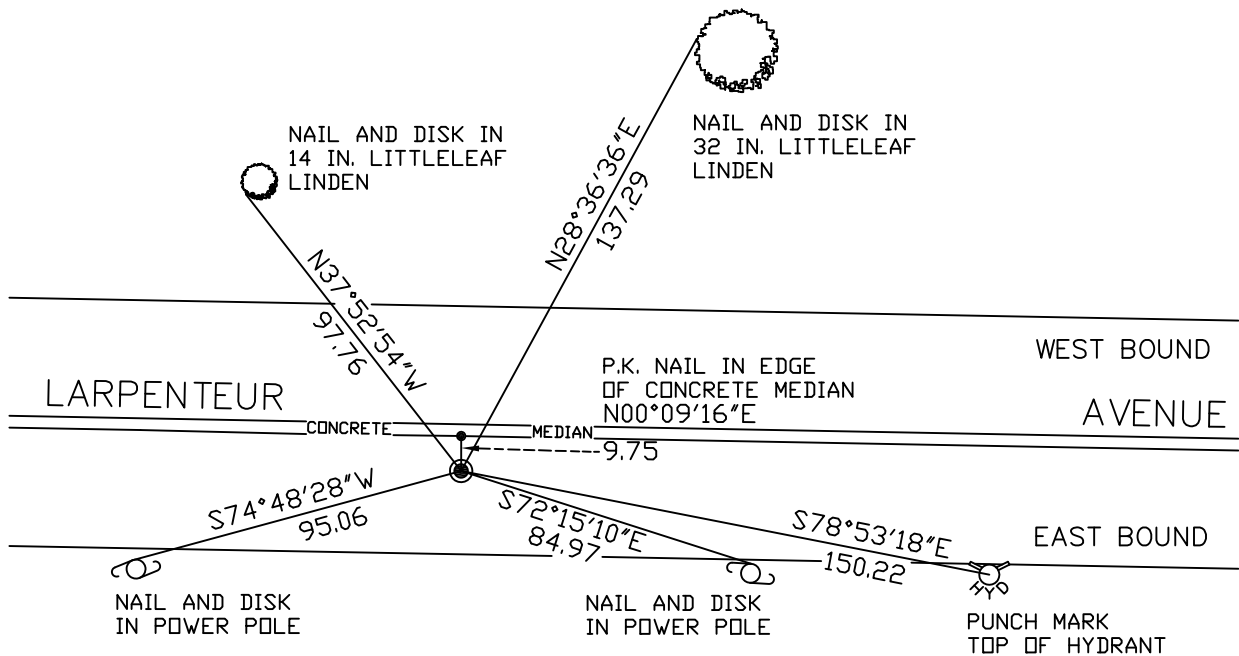

RAMSEY COUNTY
NAD83 (1986)

HOUSE
No. 858

HOUSE
No. 852

MONUMENT 448

X= 563926.605 (Easting)
Y= 173306.563 (Northing)

ALL DISTANCES ARE SHOWN IN U.S. SURVEY FEET.
BEARINGS ARE FOR TIE REFERENCE PURPOSES ONLY.

Statements of evidence relative to this corner are on the following page(s).

I hereby certify that this document and the data contained herein was prepared by me or under my direct supervision this _____ day of _____, 20____.

SIGNATURE

Minnesota License No. _____

- County Surveyor
 Deputy County Surveyor Land Surveyor

OFFICE OF COUNTY SURVEYOR

County of Ramsey

I hereby certify that this document was filed in the County Surveyor's office on the ____ day of _____, 20____.

David D. Claypool, P.L.S., County Surveyor

By _____, Deputy

MONUMENT 448

Found a brass plug, 1976.

Checked monument, August 12, 1977.

Retied monument, August 30, 1990.

Retied monument, July 12, 2002.

Retied monument, September 5, 2007.