

MONUMENT 459

CERTIFICATE OF LOCATION OF GOVERNMENT CORNER

Southeast Corner of Section 15, Township 29 North, Range 22 West, County of Ramsey, State of Minnesota.


At the corner location shown on the sketch

On August 27, 2007 found a cast iron monument, flush.

left monument as found lowered monument removed monument (explain)

On _____ placed a _____

SKETCH OF REFERENCE TIES

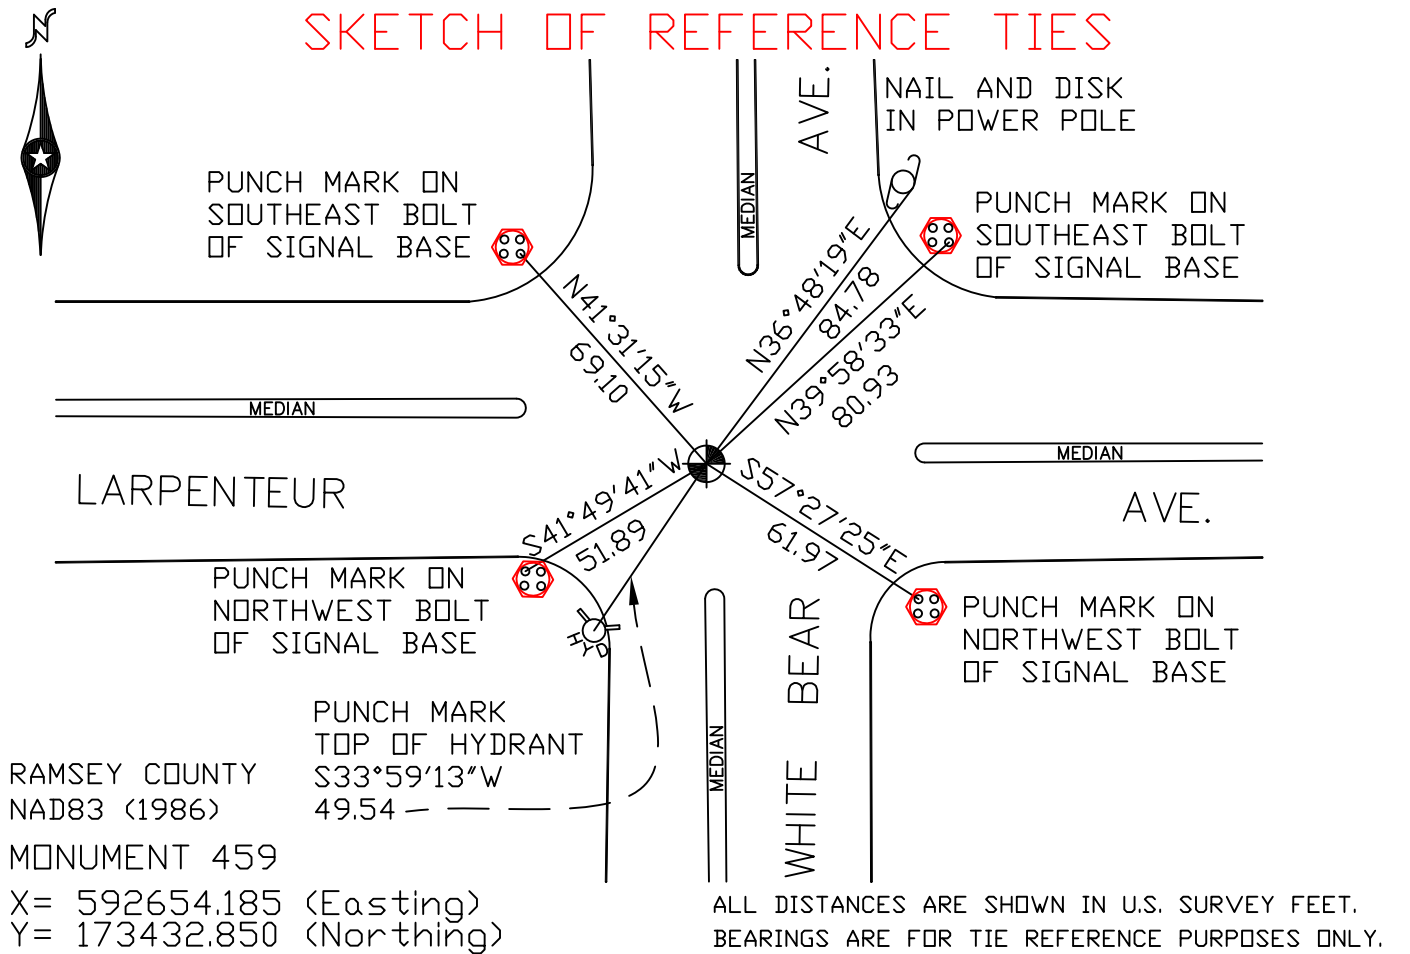

Statements of evidence relative to this corner are on the following page(s).

I hereby certify that this document and the data contained herein was prepared by me or under my direct supervision this _____ day of _____, 20____.

SIGNATURE

Minnesota License No. _____

- County Surveyor
 Deputy County Surveyor Land Surveyor

OFFICE OF COUNTY SURVEYOR

County of Ramsey

I hereby certify that this document was filed in the County Surveyor's office on the ____ day of _____, 20____.

David D. Claypool, P.L.S., County Surveyor

By _____, Deputy

MONUMENT 459

Found a cast iron monument, 1974.

Checked monument, August 12, 1977.

Found a cast iron monument broken off, 1980.

Replaced with a short cast iron monument, July 17, 1981.

Tied monument, June 8, 1990.

Retied monument, November 7, 2002.

Retied monument, August 27, 2007.