

MONUMENT 762

CERTIFICATE OF LOCATION OF GOVERNMENT CORNER

East Quarter Corner of Section 24, Township 28 North, Range 22 West, County of Ramsey, State of Minnesota.


At the corner location shown on the sketch

On September 7, 2007 found a granite monument, down 1.5 feet.

left monument as found lowered monument removed monument (explain)

On _____ placed a _____

SKETCH OF REFERENCE TIES

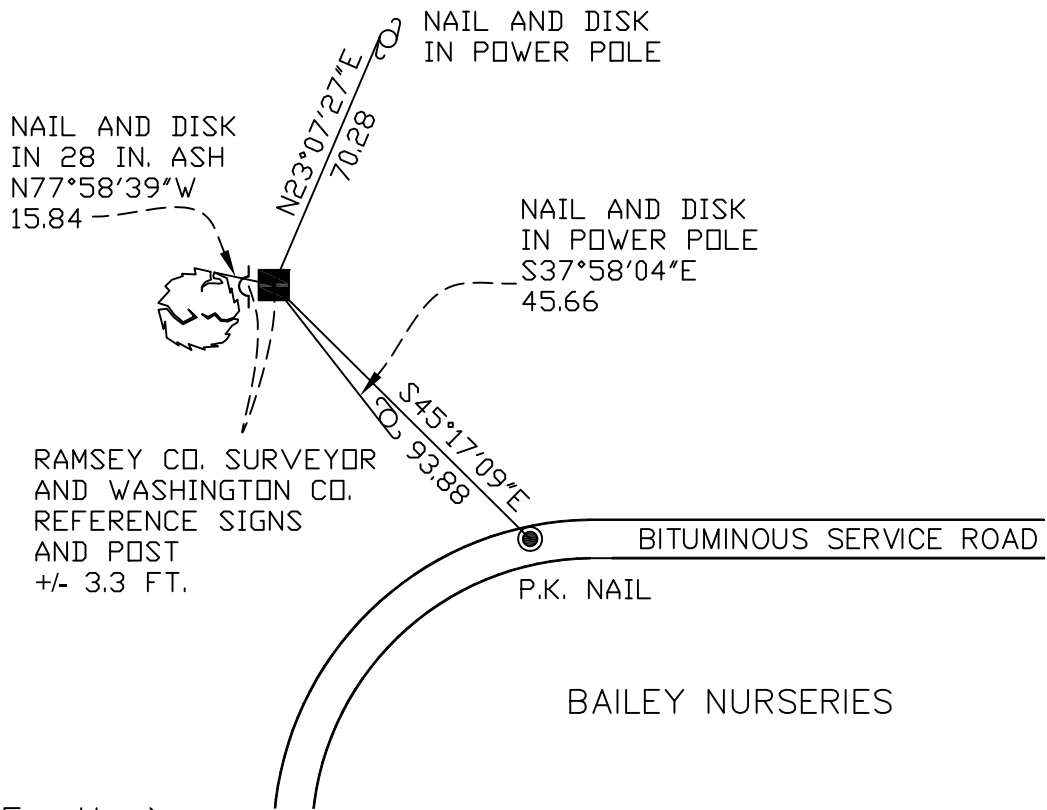

RAMSEY COUNTY
NAD83 (1986)
MONUMENT 762

X= 603429.396 (Easting)
Y= 139242.911 (Northing)

ALL DISTANCES ARE SHOWN IN U.S. SURVEY FEET.
BEARINGS ARE FOR TIE REFERENCE PURPOSES ONLY.

Statements of evidence relative to this corner are on the following page(s).

I hereby certify that this document and the data contained herein was prepared by me or under my direct supervision this _____ day of _____, 20____.

SIGNATURE

Minnesota License No. _____

- County Surveyor
 Deputy County Surveyor Land Surveyor

OFFICE OF COUNTY SURVEYOR
County of Ramsey

I hereby certify that this document was filed in the County Surveyor's office on the ____ day of _____, 20____.

David D. Claypool, P.L.S., County Surveyor

By _____, Deputy

MONUMENT 762

Found a cast iron monument up 0.1 ft.; old notes show a granite monument down 1 ft., August 6, 1974.

Cast iron monument gone; found a granite monument down +/- 1.5 ft. and retied, August 9, 1989.

Found granite monument down +/- 1.3 ft. and retied, July 31, 2002.

Retied granite monument, down 1.5 ft., September 7, 2007.