

MONUMENT 79

CERTIFICATE OF LOCATION OF GOVERNMENT CORNER

Center of Section 8, Township 30 North, Range 23 West, County of Ramsey,
State of Minnesota.


At the corner location shown on the sketch

On July 12, 2007 found a cast iron monument, flush.

left monument as found lowered monument removed monument (explain)

On _____ placed a _____

SKETCH OF REFERENCE TIES

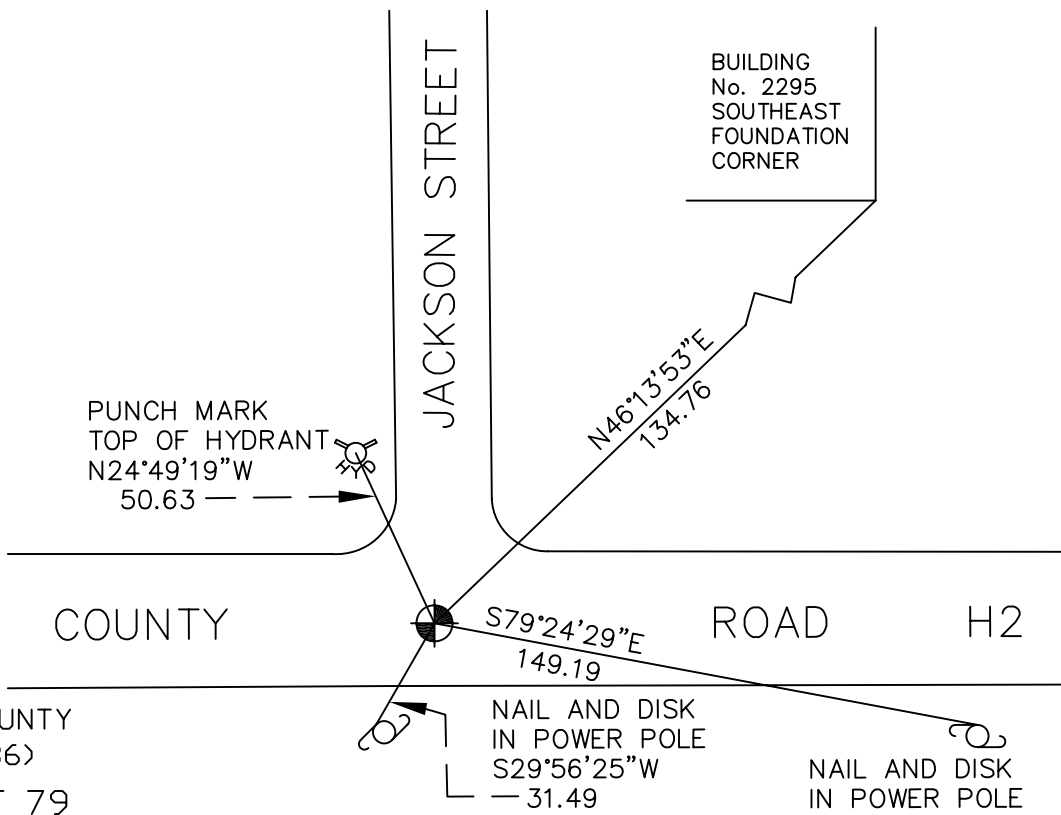

RAMSEY COUNTY
NAD83 (1986)
MONUMENT 79

X= 547691.844 (Easting)
Y= 212972.891 (Northing)

ALL DISTANCES ARE SHOWN IN U.S. SURVEY FEET.
BEARINGS ARE FOR TIE REFERENCE PURPOSES ONLY.

Statements of evidence relative to this corner are on the following page(s).

I hereby certify that this document and the data contained herein was prepared by me or under my direct supervision this _____ day of _____, 20____.

SIGNATURE

Minnesota License No. _____

- County Surveyor
 Deputy County Surveyor Land Surveyor

OFFICE OF COUNTY SURVEYOR
County of Ramsey

I hereby certify that this document was filed in the County Surveyor's office on the ____ day of _____, 20____.

David D. Claypool, P.L.S., County Surveyor

By _____, Deputy

MONUMENT 79

Found a cast iron monument flush and retied, August 19, 1974.

City of Mounds View street construction destroyed monument, 1986.

Found P.K. nail and ribbon; traversed the North 1/2 of Section 8 and Southeast of section. Set P.K. nail at recorded coordinates (west southwest 0.23 ft. from existing P.K.); checked old ties and set four P.K. nails for digging, February 22, 1999.

Set a 20 in. cast iron monument flush, June 28, 1999.

Retied monument, September 5, 2003.

Retied monument, July 12, 2007.