

# MONUMENT 8SC

## CERTIFICATE OF LOCATION OF GOVERNMENT CORNER

North Quarter Corner of Section 3, Township 30 North, Range 23 West, County of Ramsey, State of Minnesota.


At the corner location shown on the sketch

On September 22, 2009 found a cast iron monument, marked "3RD CORRECTION LINE",  
(2638.92 feet east of monument 7SC), flush.

left monument as found     lowered monument     removed monument (explain)

On \_\_\_\_\_ placed a \_\_\_\_\_

## SKETCH OF REFERENCE TIES

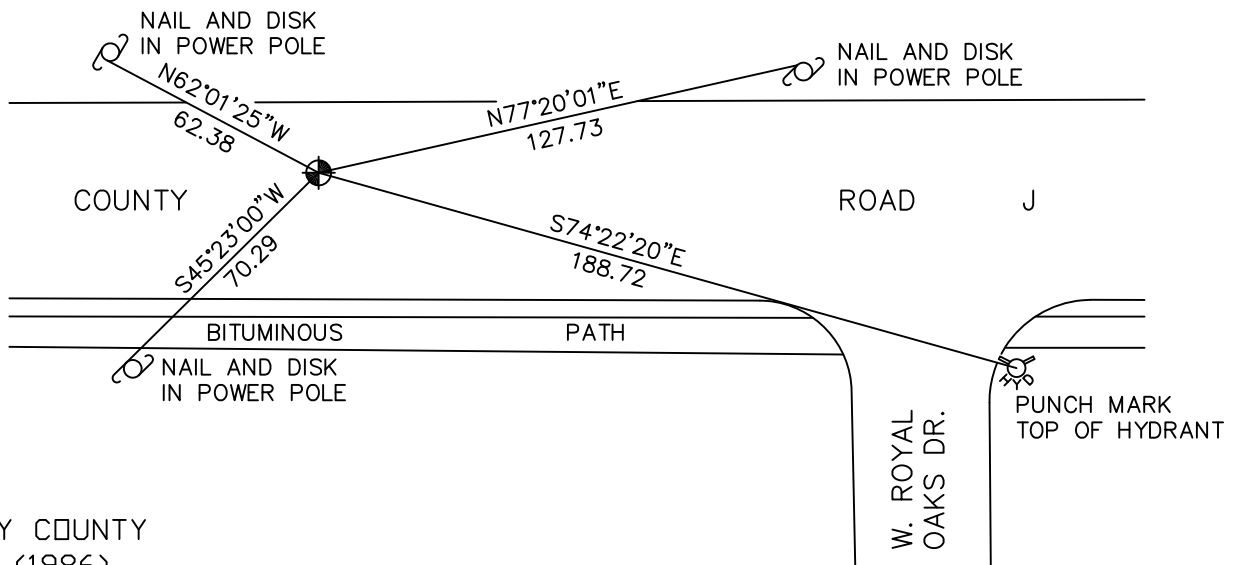

RAMSEY COUNTY  
 NAD83 (1986)

MONUMENT 8SC

X= 558130.567 (Easting)  
 Y= 221546.493 (Northing)  
 "CLOSING CORNER" IS 8.25 FT. SOUTH.

ALL DISTANCES ARE SHOWN IN U.S. SURVEY FEET.  
 BEARINGS ARE FOR TIE REFERENCE PURPOSES ONLY.

Statements of evidence relative to this corner are on the following page(s).

I hereby certify that this document and the data contained herein was prepared by me or under my direct supervision this \_\_\_\_\_ day of \_\_\_\_\_, 20\_\_\_\_.

SIGNATURE

Minnesota License No. \_\_\_\_\_

- County Surveyor  
 Deputy County Surveyor     Land Surveyor

OFFICE OF COUNTY SURVEYOR  
 County of Ramsey

I hereby certify that this document was filed in the County Surveyor's office on the \_\_\_\_\_ day of \_\_\_\_\_, 20\_\_\_\_.

SIGNATURE

Michael D. Fiebiger, P.L.S.  
 Ramsey County Surveyor

## MONUMENT 8SC

Found iron in concrete; found a granite monument, down +/- 5 in.; placed a short, (4 3/8 in.) cast iron monument, July 7, 1975.

Retied monument, December 9, 1975.

Tied out monument for road reconstruction, November 22, 1991.

Removed short cast iron monument, August 5, 1992.

Relocated monument position, August 30, 1993.

Retied monument, September 1, 1993.

Set 20 in. cast iron monument, September 8, 1993.

Placed "Set 45" concrete around monument, October 10, 1993.

Set a 20 in. cast iron monument marked "3RD CORRECTION LINE", 8.25 ft. north of original granite monument location, October 21, 1995.

Tied monument 8SC, December 14, 1998.

Retied monument, June, 2004.

Retied monument, September 22, 2009.