

# MONUMENT 127

## CERTIFICATE OF LOCATION OF GOVERNMENT CORNER

Center of Section 18, Township 30 North, Range 23 West, County of Ramsey, State of Minnesota.


At the corner location shown on the sketch

On July 13, 2010 found a cast iron monument, within a cast iron manhole assembly.

left monument as found       raised/lowered monument       removed monument (explain)

On \_\_\_\_\_ placed a \_\_\_\_\_

### SKETCH OF REFERENCE TIES

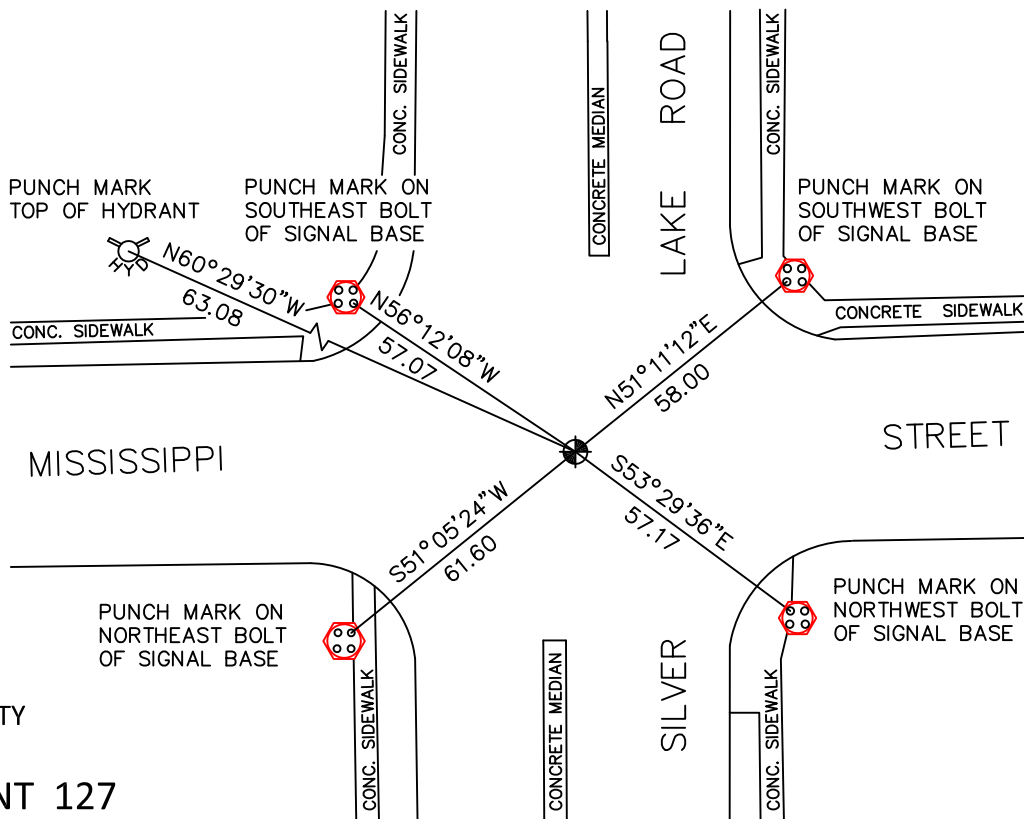

RAMSEY COUNTY  
NAD83 (1986)

### MONUMENT 127

X= 542469.019 (Easting)  
Y= 207602.258 (Northing)

ALL DISTANCES ARE SHOWN IN U.S. SURVEY FEET.  
BEARINGS ARE FOR TIE REFERENCE PURPOSES ONLY.

Statements of evidence relative to this corner are on the following page.

I hereby certify that this document has been prepared by me or under my direct supervision this \_\_\_\_\_ day of \_\_\_\_\_, 20\_\_\_\_.

Minnesota License No. \_\_\_\_\_

- County Surveyor       Deputy County Surveyor       Land Surveyor

OFFICE OF COUNTY SURVEYOR  
County of Ramsey

I hereby certify that this document was filed in the County Surveyor's office this \_\_\_\_\_ day of \_\_\_\_\_, 20\_\_\_\_.

Michael D. Fiebiger, P.L.S.  
Ramsey County Surveyor

## MONUMENT 127

Found a cast iron monument flush, June 17, 1974.

Tied monument, June 26, 1975.

Retied monument, January 14, 1992.

Removed 20 in. cast iron monument; found 1 in. by 18 in. long iron, 21 in. down. Removed iron and set a 20 in. cast iron in place of iron. Iron not in same place as old cast iron monument. Set manhole assembly, November 13, 1998.

Tied out monument for removal during reconstruction of Silver Lake Road, April 12, 2002.

Removed manhole and 20 in. cast iron monument, May 8, 2003.

Reset a 20 in. cast iron monument down 18 in; contractor to set a cast iron manhole assembly, November 17, 2003.

Tied monument, March 1, 2005.

Retied monument, July 13, 2010.