

MONUMENT 135N

CERTIFICATE OF LOCATION OF GOVERNMENT CORNER

Monument on the North-South Quarter Line, North of Center of Section 14,
Township 30 North, Range 23 West, County of Ramsey, State of Minnesota.


At the corner location shown on the sketch

On April 29, 2010 found a granite monument, up 0.6 feet.

left monument as found lowered monument removed monument (explain)

On _____ placed a _____

SKETCH OF REFERENCE TIES

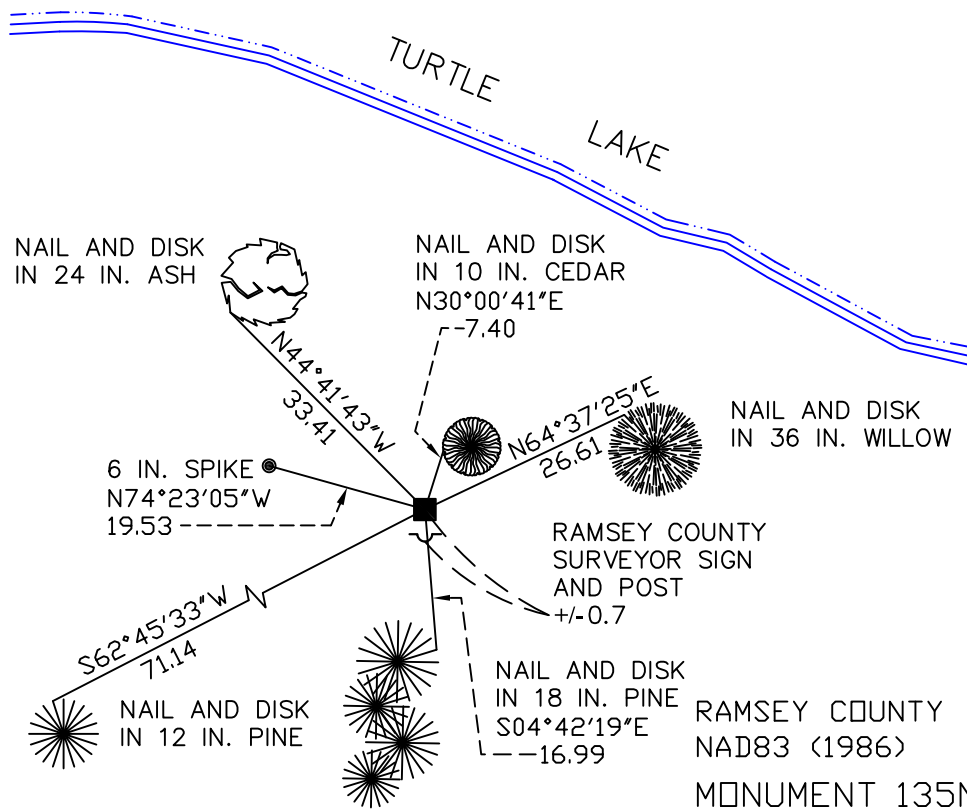

ALL DISTANCES ARE SHOWN IN U.S. SURVEY FEET.
BEARINGS ARE FOR TIE REFERENCE PURPOSES ONLY.

X= 563557.771 (Easting)
Y= 209100.274 (Northing)

Statements of evidence relative to this corner are on the following page(s).

I hereby certify that this document and the data contained herein was prepared by me or under my direct supervision this _____ day of _____, 20____.

SIGNATURE

Minnesota License No. _____

- County Surveyor
 Deputy County Surveyor Land Surveyor

OFFICE OF COUNTY SURVEYOR
County of Ramsey

I hereby certify that this document was filed in the County Surveyor's office on the _____ day of _____, 20____.

SIGNATURE

Michael D. Fiebiger, P.L.S.
Ramsey County Surveyor

MONUMENT 135N

Found a granite monument, up +/-1 ft., January 16, 1987.

Tied monument, May 4, 1990.

Retied monument, slight lean to the south; set a sign and post +/-0.7 ft. south, July 7, 2003.

Retied monument, April 29, 2010.