

# MONUMENT 267

## CERTIFICATE OF LOCATION OF GOVERNMENT CORNER

Northeast Corner of Section 32, Township 30 North, Range 22 West, County of Ramsey, State of Minnesota.


At the corner location shown on the sketch

On August 9, 2011 found a P.K. nail flush in bituminous road.

left monument as found       raised/lowered monument       removed monument (explain)

On August 9, 2011 placed a a cast iron monument, flush.

### SKETCH OF REFERENCE TIES

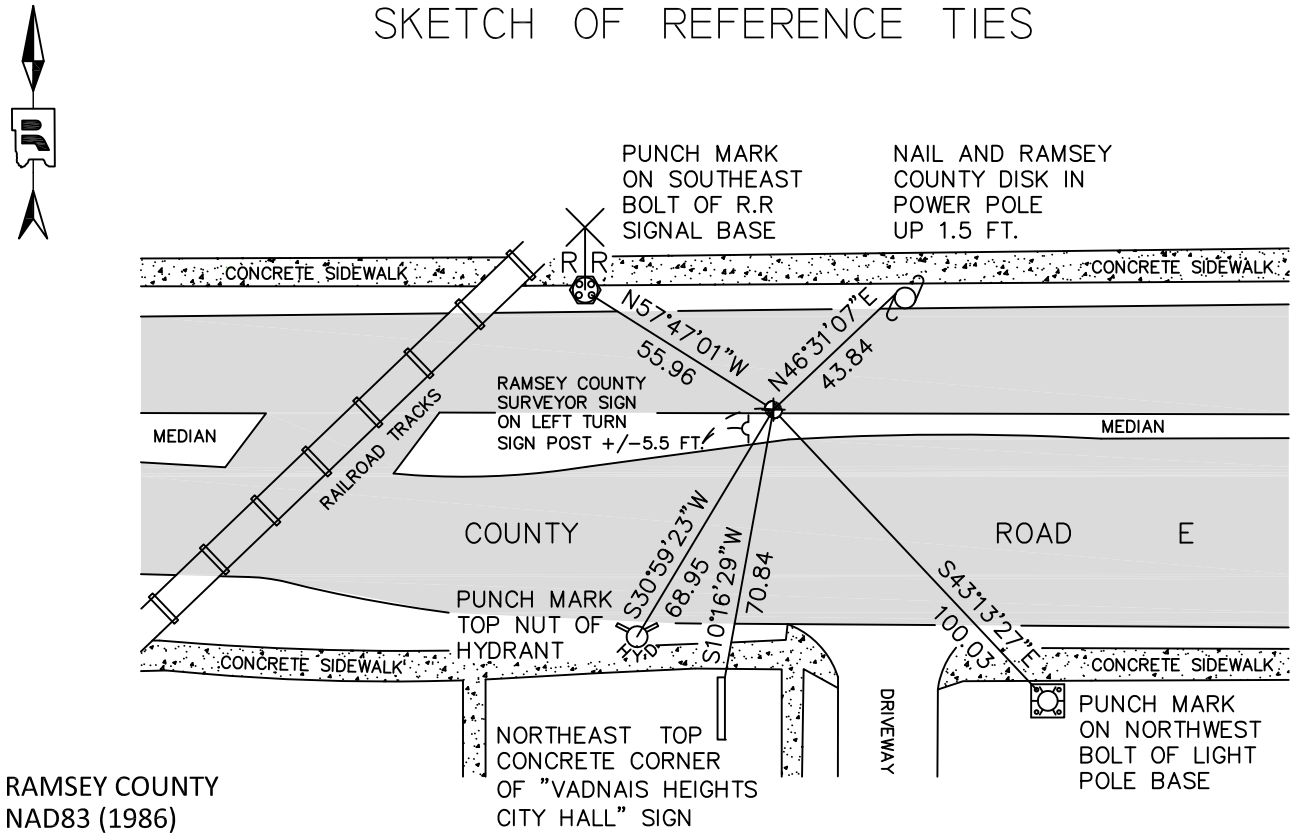

RAMSEY COUNTY  
NAD83 (1986)

### MONUMENT 267

X= 581882.814 (Easting)  
Y= 194676.783 (Northing)

ALL DISTANCES ARE SHOWN IN U.S. SURVEY FEET.  
BEARINGS ARE FOR TIE REFERENCE PURPOSES ONLY.

Statements of evidence relative to this corner are on the following page.

I hereby certify that this document was prepared by me or under my direct supervision and that I am a duly Licensed Land Surveyor under the laws of the State of Minnesota.

Daniel D. Baar      Date \_\_\_\_\_  
Minnesota License No. 45816

County Surveyor       Land Surveyor  
 Deputy County Surveyor

OFFICE OF COUNTY SURVEYOR  
County of Ramsey

I hereby certify that this document was filed in the County Surveyor's office this \_\_\_\_\_ day of \_\_\_\_\_, 20 \_\_\_\_.

Craig W. Hinzman, L.S.  
Ramsey County Surveyor

## MONUMENT 267

In establishing the Northeast Corner of Section 32. Measured east from 1/4 Corner between Sections 29 and 32 - 2619.80 ft. which checked the line of fence running South. Government witness trees gone. Fixed Corner, tied it and set monument, 1895.

Found pipe down 0.3 ft., April, 1974.

Found 1 in. diameter, 2 ft. long solid iron, down 4 1/4 in., May 16, 1975.

Found granite monument down 1.16 ft. and 0.89 ft. East and 0.18 ft. North of the found iron, May 19, 1975.

Placed a cast iron monument over granite monument, May 20, 1975. Checked and tied cast iron monument, June 28, 1991.

Set a 20 in. cast iron monument, [sic] September, 1994.

Tied monument, December 8, 1998.

Retied monument, October 26, 2005.

Tied out monument for removal during road re-construction, August 18, 2006.

Set a P.K. nail at monument position, May 30, 2007.

Replaced P.K. nail with a 4 3/8 in. cast iron monument and tied, August 9, 2011.