

# MONUMENT 34

## CERTIFICATE OF LOCATION OF GOVERNMENT CORNER

East Quarter Corner of Section 3, Township 30 North, Range 23 West, County of Ramsey, State of Minnesota.


At the corner location shown on the sketch

On November 4, 2011 found a cast iron monument, flush.

left monument as found       raised/lowered monument       removed monument (explain)

On \_\_\_\_\_ placed a \_\_\_\_\_

### SKETCH OF REFERENCE TIES

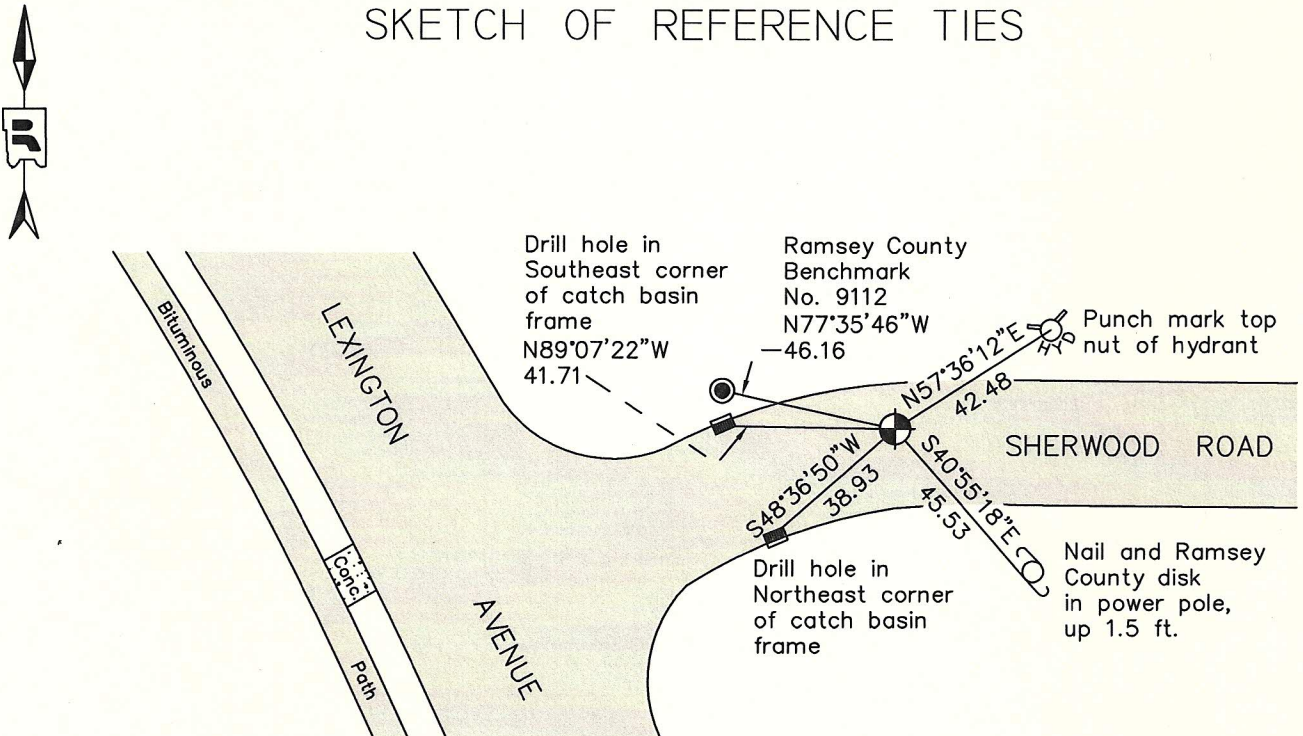

RAMSEY COUNTY  
NAD83 (1986)

### MONUMENT 34

X= 560812.486 (Easting)  
Y= 218294.784 (Northing)

ALL DISTANCES ARE SHOWN IN U.S. SURVEY FEET.  
BEARINGS ARE FOR TIE REFERENCE PURPOSES ONLY.

Statements of evidence relative to this corner are on the following page.

I hereby certify that this document was prepared by me or under my direct supervision and that I am a duly Licensed Land Surveyor under the laws of the State of Minnesota.

Daniel D. Baar      8-15-12  
Daniel D. Baar      Date

Minnesota License No. 45816

County Surveyor       Land Surveyor  
 Deputy County Surveyor

OFFICE OF COUNTY SURVEYOR  
County of Ramsey

I hereby certify that this document was filed in the County Surveyor's office this 15<sup>th</sup> day of August, 20 12.

Craig W. Hinzman  
Craig W. Hinzman, L.S.  
Ramsey County Surveyor

# MONUMENT 34

East Quarter Corner of Section 3, Township 30 North, Range 23 West

Set 1/4 Section post, B. Oak 12 N62°E 75, "Do" (B. Oak) 8 S60°W 31, December 10, 1847.

In establishing the 1/4 Corner between Sections 2 and 3, found old stake at 1/4 corner, Government Witness trees gone, tied it, December, 1895.

Set monument, July 11, 1898.

Found iron monument in concrete. Granite down 0.58 ft. Set short (4 3/8 in.) cast iron, July 17, 1975.

Tied monument, July 29, 1975.

Monument removed for Construction Department, 1990.

Set 20 in. cast iron monument flush, October 14, 1992.

Tied monument, September 2, 1993.

Cemented monument and re-drilled hole, June 14, 1999.

Cemented monument, August 10, 2006.

Retied monument, August 16, 2006.

Retied monument, flush, November 4, 2011.