

MONUMENT 349

CERTIFICATE OF LOCATION OF GOVERNMENT CORNER

Southwest Corner of Section 5, Township 29 North, Range 23 West, County of Ramsey, State of Minnesota.


At the corner location shown on the sketch

On July 6, 2011 found cast iron monument, flush.

left monument as found raised/lowered monument removed monument (explain)

On _____ placed a _____

SKETCH OF REFERENCE TIES

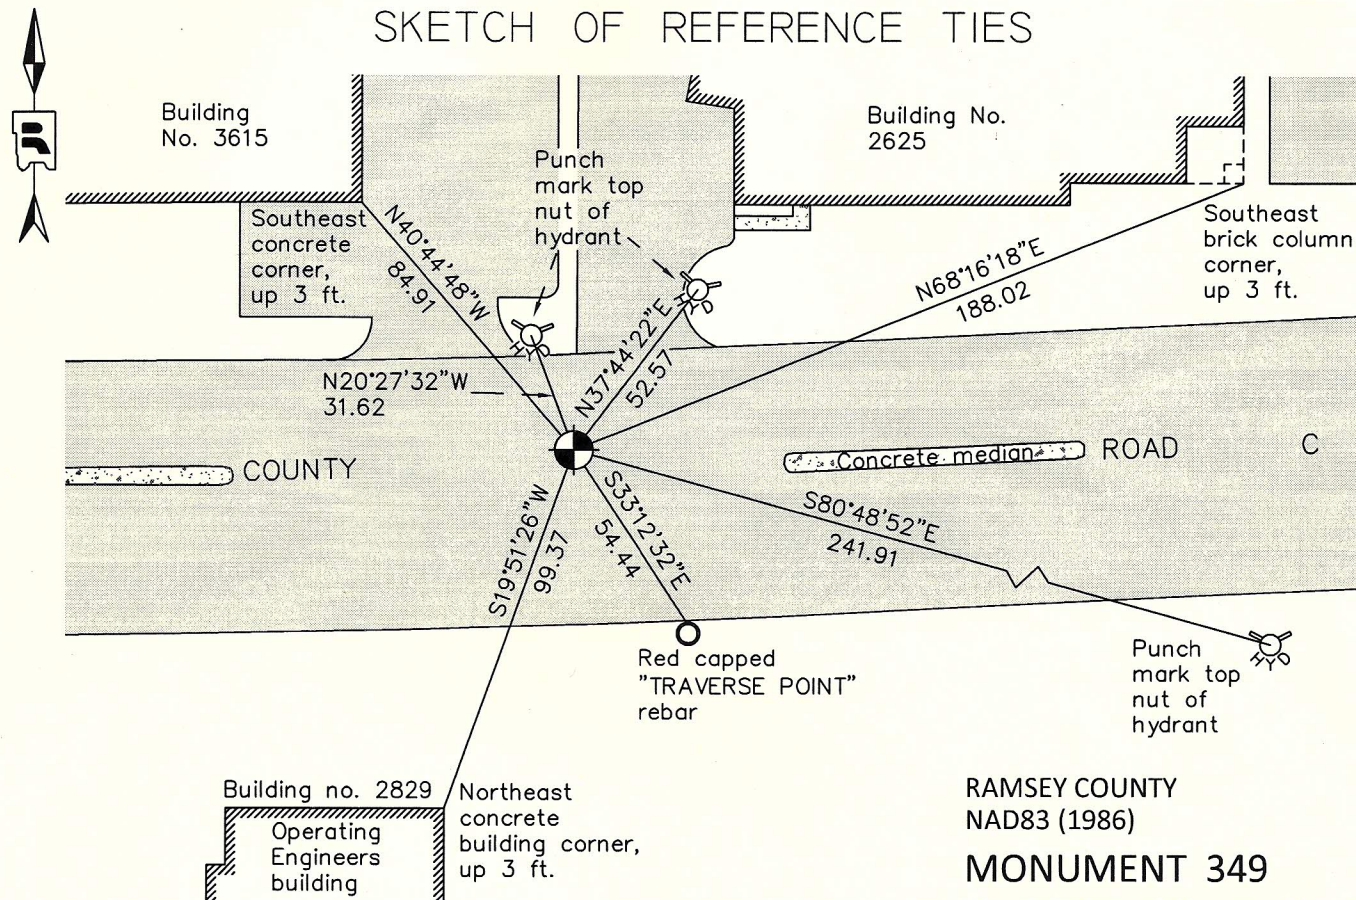

ALL DISTANCES ARE SHOWN IN U.S. SURVEY FEET.
BEARINGS ARE FOR TIE REFERENCE PURPOSES ONLY.

RAMSEY COUNTY
NAD83 (1986)
MONUMENT 349
X= 545393.120 (Easting)
Y= 183719.110 (Northing)

Statements of evidence relative to this corner are on the following page.

I hereby certify that this document was prepared by me or under my direct supervision and that I am a duly Licensed Land Surveyor under the laws of the State of Minnesota.

Daniel D. Baar 8-10-12
Daniel D. Baar Date
Minnesota License No. 45816

- County Surveyor Land Surveyor
 Deputy County Surveyor

OFFICE OF COUNTY SURVEYOR
County of Ramsey

I hereby certify that this document was filed in the County Surveyor's office this 10th day of August, 20 12.

Craig W. Hinzman
Craig W. Hinzman, L.S.
Ramsey County Surveyor

MONUMENT 349

Southwest Corner of Section 5, Township 29 North, Range 23 West

Set Post Corner to Sections 5, 6, 7, & 8; Bur Oak 11 N74°E 80, "Do" (Bur Oak) 12 N21°W 1.25, November 3, 1847.

Found monument at Southwest Corner of Section 5 set by Hennepin County, December 21, 1899.

Found granite monument flush, August, 1975.

Monument destroyed by construction, 1979.

Replaced cast iron monument and tied, 1981.

Monument checked, January 16, 1991.

Retied monument in the inner west bound lane, March 28, 2001.

Retied monument, June 27, 2006.

Found cast iron monument even with surface of concrete, road in good condition. All ties exist, did not remeasure, August 8, 2006. (Hennepin County)

Retied cast iron monument, flush, July 6, 2011.