

# MONUMENT 364

## CERTIFICATE OF LOCATION OF GOVERNMENT CORNER

North Quarter Corner Section 9, Township 29 North, Range 22 West, County of Ramsey, State of Minnesota.


At the corner location shown on the sketch

On July 7, 2011 found a cast iron monument, flush in bituminous road.

left monument as found       raised/lowered monument       removed monument (explain)

On \_\_\_\_\_ placed a \_\_\_\_\_

### SKETCH OF REFERENCE TIES

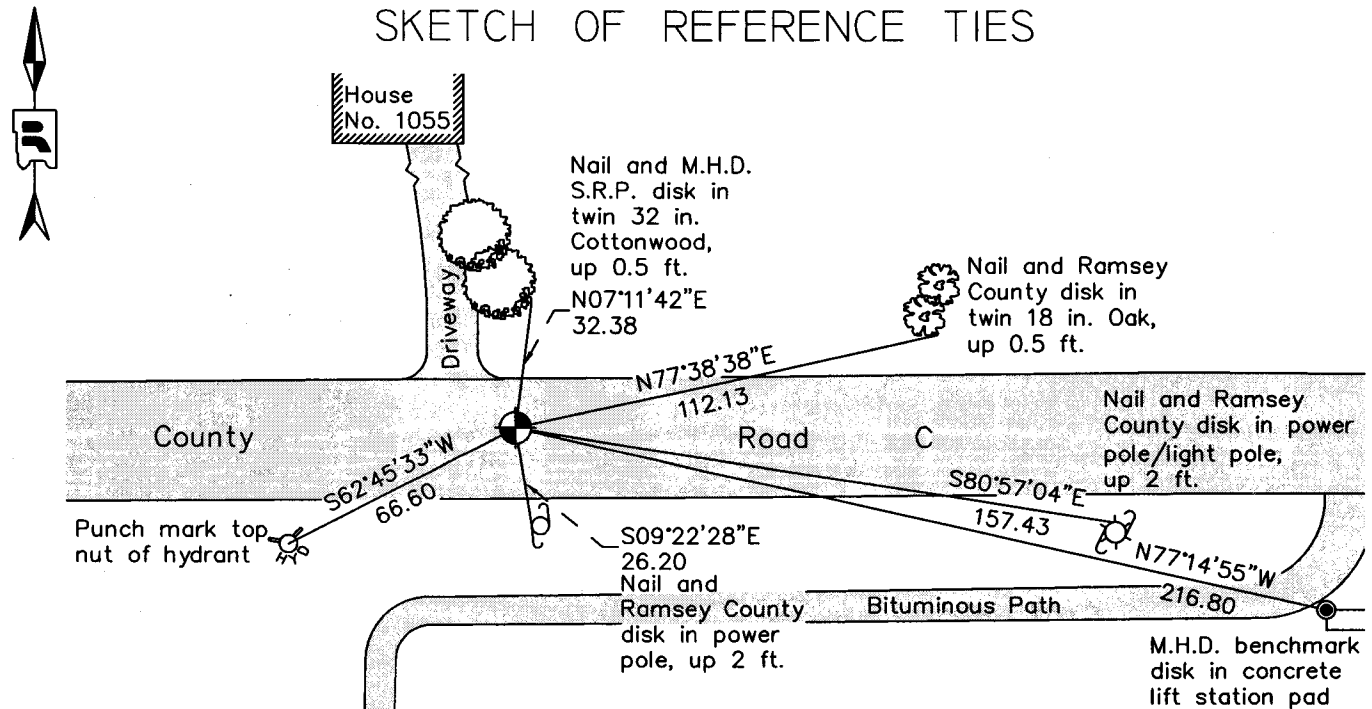

RAMSEY COUNTY  
NAD83 (1986)  
**MONUMENT 364**

X= 584670.740 (Easting)  
Y= 183943.210 (Northing)

ALL DISTANCES ARE SHOWN IN U.S. SURVEY FEET.  
BEARINGS ARE FOR TIE REFERENCE PURPOSES ONLY.

Statements of evidence relative to this corner are on the following page.

I hereby certify that this document was prepared by me or under my direct supervision and that I am a duly Licensed Land Surveyor under the laws of the State of Minnesota.

Daniel D. Baar      7-20-12  
Daniel D. Baar      Date  
Minnesota License No. 45816

County Surveyor       Land Surveyor  
 Deputy County Surveyor

OFFICE OF COUNTY SURVEYOR  
County of Ramsey

I hereby certify that this document was filed in the County Surveyor's office this 20th day of July, 20 12.

Craig W. Hinzman  
Craig W. Hinzman, L.S.  
Ramsey County Surveyor

# MONUMENT 364

North Quarter Corner Section 9, Township 29 North, Range 22 West

Set 1/4 Section post, W. Oak 12 S85°E 3.20, November 29, 1847.

In establishing the 1/4 Corner between Section 4 and 9 found boulder monument and iron stake, Government Witness trees gone, set monument August 18, 1898.

Found 1 3/4 in. Iron Monument tipped, April, 1967 (The origin of the iron monument has not been determined).

Found a cast iron monument in place, down 0.3 ft., 1974 (The origin of the cast iron monument has not been determined).

Checked monument, September 12, 1977.

Tied monument, May 13, 1981.

Checked monument, August 8, 1990.

Tied and removed 20 in. cast iron monument for road maintenance, April 23, 1993.

Replaced 20 in. cast iron monument, September 8, 1993.

Tied monument, December 9, 1999.

Retied monument, June 28, 2006.

Retied a cast iron monument, flush in bituminous road, July 7, 2011.