

# MONUMENT 378

## CERTIFICATE OF LOCATION OF GOVERNMENT CORNER

East Quarter Corner of Section 10, Township 29 North, Range 23 West, County of Ramsey, State of Minnesota.


At the corner location shown on the sketch

On July 6, 2011 found a cast iron monument, within a cast iron manhole assembly.

left monument as found       raised/lowered monument       removed monument (explain)

On \_\_\_\_\_ placed a \_\_\_\_\_

### SKETCH OF REFERENCE TIES

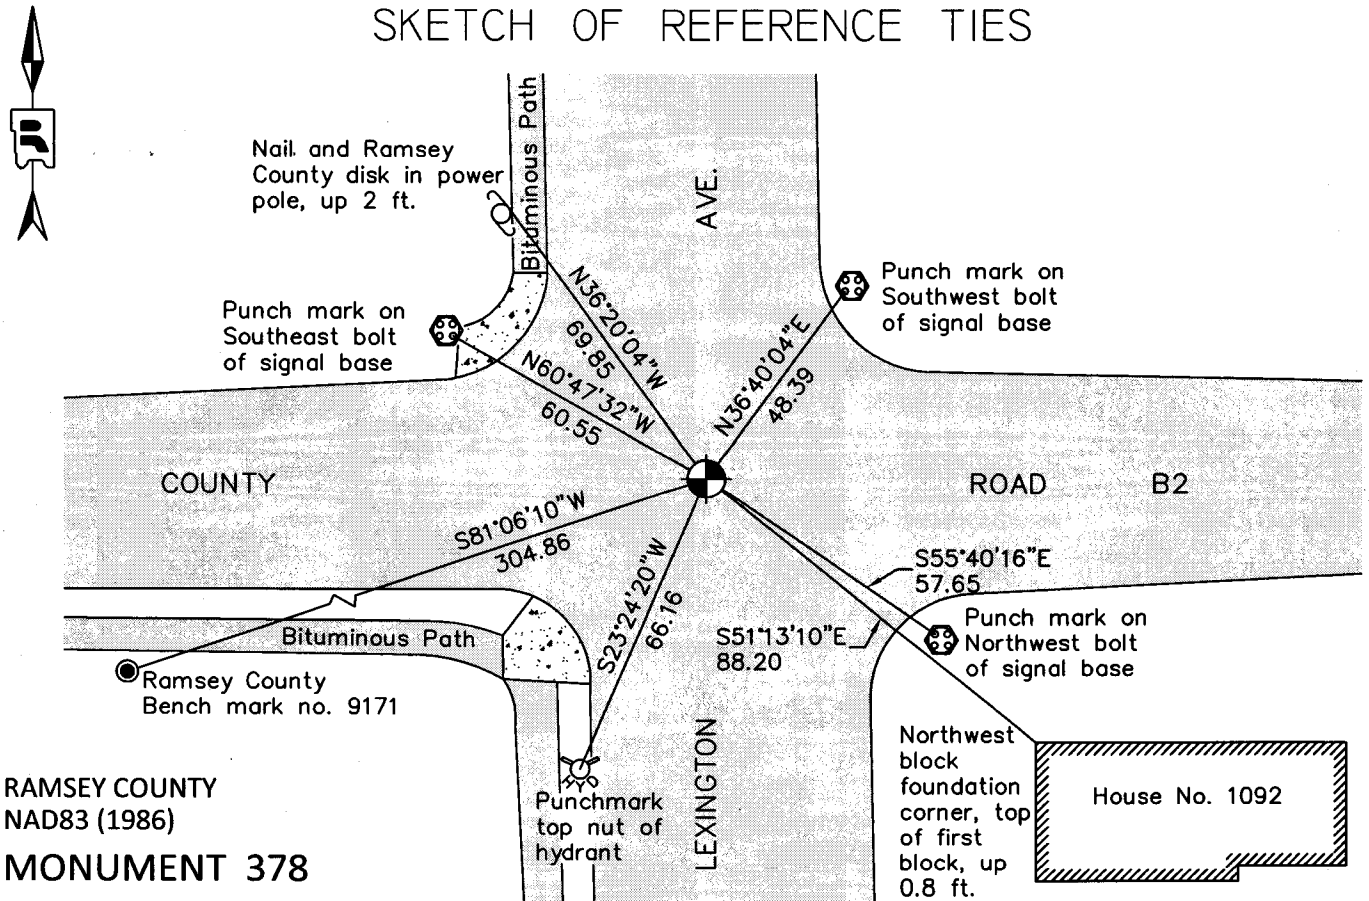

RAMSEY COUNTY  
NAD83 (1986)  
**MONUMENT 378**

X= 561237.059 (Easting)  
Y= 181219.246 (Northing)

ALL DISTANCES ARE SHOWN IN U.S. SURVEY FEET.  
BEARINGS ARE FOR TIE REFERENCE PURPOSES ONLY.

Statements of evidence relative to this corner are on the following page.

I hereby certify that this document was prepared by me or under my direct supervision and that I am a duly Licensed Land Surveyor under the laws of the State of Minnesota.

Daniel D. Baar      7-24-12  
Daniel D. Baar      Date  
Minnesota License No. 45816

- County Surveyor       Land Surveyor  
 Deputy County Surveyor

OFFICE OF COUNTY SURVEYOR  
County of Ramsey

I hereby certify that this document was filed in the County Surveyor's office this 24<sup>th</sup> day of July, 20 12.

Craig W. Hinzman  
Craig W. Hinzman, L.S.  
Ramsey County Surveyor

# MONUMENT 378

East Quarter Corner of Section 10, Township 29 North, Range 23 West

Set 1/4 Section Post, Bur Oak 15 S9°W 43; "Do" (Bur Oak) 12 N10°E 46;  
November 03, 1847.

The 1/4 Corner between Sections 10 and 11 was fixed in May, 1897.  
Found old iron stake, Government witness trees gone, set monument.

Found granite monument, down 2 in. and tied, July 23, 1974.

Placed cast iron cap and bolt monument, October 10, 1974.

Monument destroyed by construction, 1979.

Set 20 in. cast iron monument, April 17, 1981.

Tied monument, August 10, 1990.

Tied monument and a 20 in. cast iron monument set 1.5 ft. below grade,  
April 17 and 28, 1998.

Set cast iron manhole assembly over monument, July 24, 1998.

Retied monument, July 10, 2006.

Retied a cast iron monument, within a cast iron manhole assembly, July 6, 2011.