

MONUMENT 411

CERTIFICATE OF LOCATION OF GOVERNMENT CORNER

Northeast Corner of Section 16, Township 29 North, Range 22 West, County of Ramsey, State of Minnesota.


At the corner location shown on the sketch

On June 27, 2011 found a cast iron monument, within a cast iron manhole assembly.

left monument as found raised/lowered monument removed monument (explain)

On _____ placed a _____

SKETCH OF REFERENCE TIES

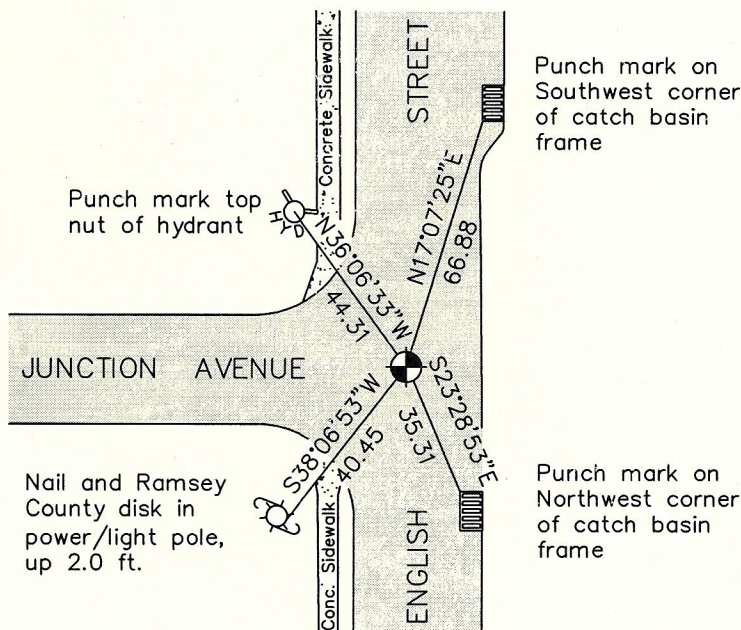

RAMSEY COUNTY
NAD83 (1986)

MONUMENT 411

X= 587326.982 (Easting)
Y= 178712.990 (Northing)

ALL DISTANCES ARE SHOWN IN U.S. SURVEY FEET.
BEARINGS ARE FOR TIE REFERENCE PURPOSES ONLY.

Statements of evidence relative to this corner are on the following page.

I hereby certify that this document was prepared by me or under my direct supervision and that I am a duly Licensed Land Surveyor under the laws of the State of Minnesota.

Daniel D. Baar 7-31-12
Daniel D. Baar Date
Minnesota License No. 45816

- County Surveyor Land Surveyor
 Deputy County Surveyor

OFFICE OF COUNTY SURVEYOR
County of Ramsey

I hereby certify that this document was filed in the County Surveyor's office this 31st day of JULY, 20 12.

Craig W. Hinzman
Craig W. Hinzman, L.S.
Ramsey County Surveyor

MONUMENT 411

Northeast Corner of Section 16, Township 29 North, Range 22 West

Set post Corner to Sections 9, 10, 15, & 16, Bur Oak 10, S8°E 46; "Do" (Bur Oak) 9, N40°E 59; November 29, 1847.

In establishing the Northeast Corner of Section 16, found old stake at Section Corner 4 feet underground, retied it and set monument, Government trees gone, November, 1899.

Found cast iron monument flush and tied, February 20, 1976 (The origin of the cast iron monument has not been determined).

Retied monument, October 19, 2000.

Tied and removed cast iron monument for City of Maplewood construction, May 22, 2002.

Found 3/4 in. pipe down 2.2 ft. while digging to reset cast iron monument. Iron pipe matches monument position; set a 20 in. cast iron monument within a cast iron manhole assembly, October 20, 2002.

Tied monument, August 30, 2006.

Retied cast iron monument within a cast iron manhole assembly, June 27, 2011.