

MONUMENT 417

CERTIFICATE OF LOCATION OF GOVERNMENT CORNER

Northeast Corner of Section 13, Township 29 North, Range 22 West, County of Ramsey, State of Minnesota.


At the corner location shown on the sketch

On June 23, 2011 found a granite monument, within a cast iron manhole assembly.

left monument as found raised/lowered monument removed monument (explain)

On _____ placed a _____

SKETCH OF REFERENCE TIES

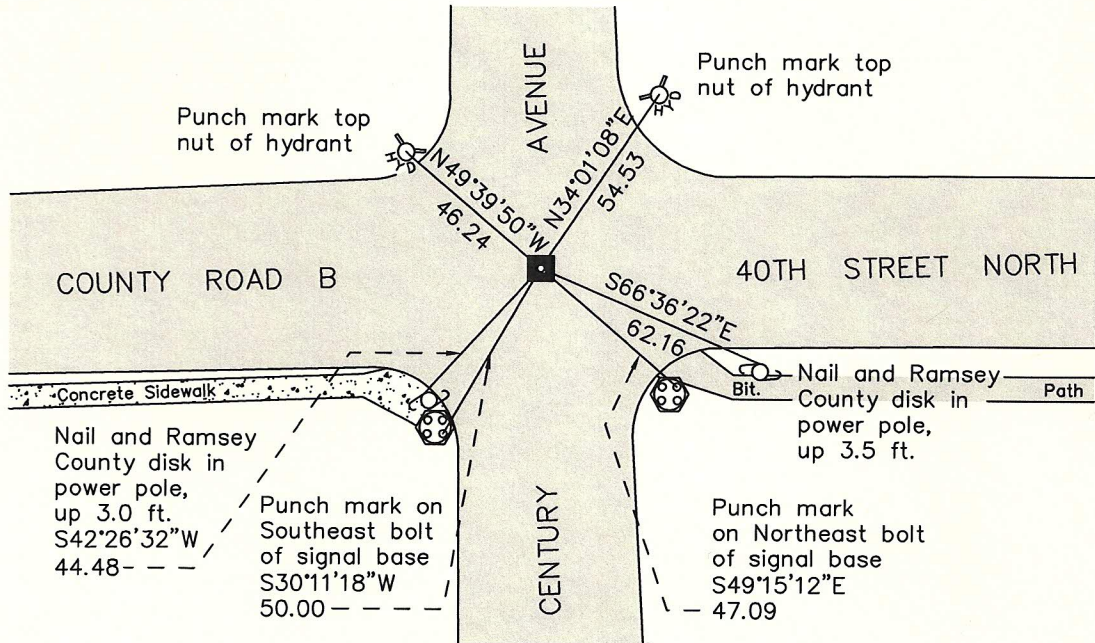

RAMSEY COUNTY
NAD83 (1986)

MONUMENT 417

X= 603100.664 (Easting)
Y= 178873.112 (Northing)

ALL DISTANCES ARE SHOWN IN U.S. SURVEY FEET.
BEARINGS ARE FOR TIE REFERENCE PURPOSES ONLY.

Statements of evidence relative to this corner are on the following page.

I hereby certify that this document was prepared by me or under my direct supervision and that I am a duly Licensed Land Surveyor under the laws of the State of Minnesota.

Daniel D. Baar 8-15-12
Daniel D. Baar Date
Minnesota License No. 45816

County Surveyor Land Surveyor
 Deputy County Surveyor

OFFICE OF COUNTY SURVEYOR
County of Ramsey

I hereby certify that this document was filed in the County Surveyor's office this 15th day of August, 20 12.

Craig W. Hinzman
Craig W. Hinzman, L.S.
Ramsey County Surveyor

MONUMENT 417

Northeast Corner of Section 13, Township 29 North, Range 22 West

Set post at cor. to Sections 7, 12, 13 & 18, B. Oak 12 S58°E 45, W. Oak 10 N53°W 32, W. Oak 12 S27°W 95, Oct. 9th, 1847.

The Northeast Corner of Section 13 was fixed from stakes found in North St. Paul proper, and also found old stake at Section Corner, Government Witness trees gone, tied it and set monument September 21, 1897.

Found 1/2 in. iron pipe. Found granite monument, down 0.92 ft., May 5, 1976.

Set a 10 in. cast iron monument over granite monument, August 6, 1976.

Checked and tied monument, July 5, 1984.

Retied monument, October 19, 2000.

Removed 10 in. cast iron monument. Placed a cast iron manhole assembly over granite monument, June 22, 2005.

Tied monument, August 31, 2006.

Retied granite monument, within a cast iron manhole assembly, June 23, 2011.