

MONUMENT 145

CERTIFICATE OF LOCATION OF SECTION SUBDIVISION MONUMENT

Center of Section 15, Township 30 North, Range 22 West, County of Ramsey, State of Minnesota.


At the corner location shown on the sketch

On September 9, 2012 found a "Ramsey County" cast iron monument in bituminous road.

left monument as found raised/lowered monument removed monument (explain)

On _____ placed a _____

SKETCH OF REFERENCE TIES

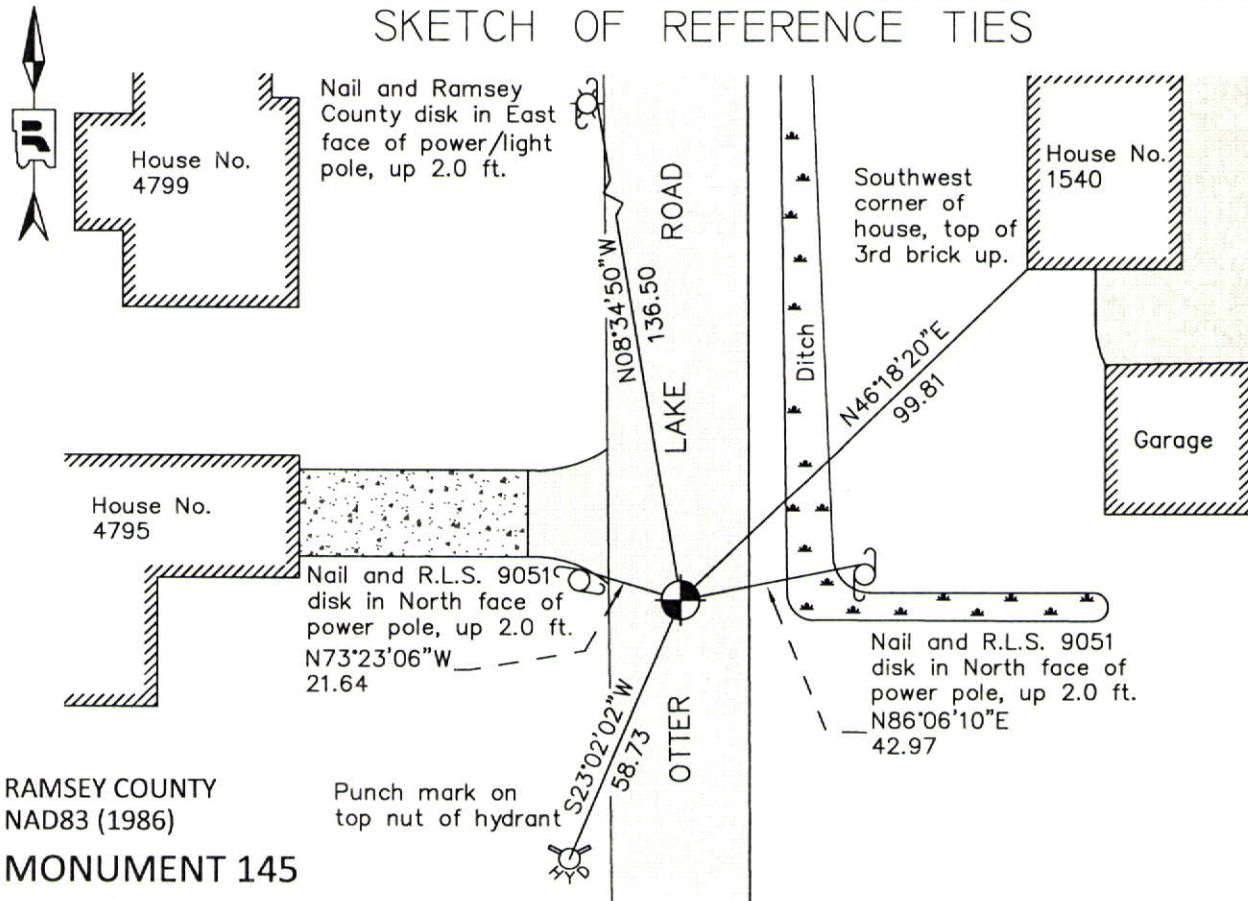

RAMSEY COUNTY
NAD83 (1986)

MONUMENT 145

X= 589770.440 (Easting)
Y= 207890.133 (Northing)

ALL DISTANCES ARE SHOWN IN U.S. SURVEY FEET.
BEARINGS ARE FOR TIE REFERENCE PURPOSES ONLY.

Statements of evidence relative to this corner are on the following page.

I hereby certify that this document was prepared by me or under my direct supervision and that I am a duly Licensed Land Surveyor under the laws of the State of Minnesota.

Daniel D. Baar 12-15-14
Daniel D. Baar Date
Minnesota License No. 45816

- County Surveyor Land Surveyor
 Deputy County Surveyor

OFFICE OF COUNTY SURVEYOR
County of Ramsey

I hereby certify that this document was filed in the County Surveyor's office this 15th day of December, 20 14.

Craig W. Hinzman
Craig W. Hinzman, L.S.
Ramsey County Surveyor

MONUMENT 145

Center of Section 15, Township 30 North, Range 22 West

Fixed the Center of Section of 15 by Intersection, March 6, 1902.

Monument set, December 16, 1902.

Checked granite monument, February, 1948.

Checked granite monument, June, 1965.

Found a granite monument, down 0.2 ft., May 21, 1974.

Tied monument, October 10, 1974.

Set a cast iron cap and bolt monument, May 27, 1976.

Tied monument, down 0.2 ft., September 21, 1989.

Retied monument, September 30, 1999.

Retied monument, September 24, 2004.

Retied monument, October 13, 2009.

Monument removed during culvert install. Monument removed was a 20 in. cast iron monument, dug down +/-4 ft. and found nothing more, July 17, 2012.

Re-established position using local ties, placed a "Ramsey County" 20 in. cast iron monument flush in bituminous road; tied, September 19, 2012.