

# MONUMENT 230

## CERTIFICATE OF LOCATION OF FOUND MONUMENT

East Quarter Corner of Section 29, Township 30 North, Range 23 West, County of Ramsey, State of Minnesota.


At the corner location shown on the sketch

On May 29, 2012 found a 3 in. brass disk, flush in concrete bridge deck.

left monument as found       raised/lowered monument       removed monument (explain)

On \_\_\_\_\_ placed a \_\_\_\_\_

### SKETCH OF REFERENCE TIES

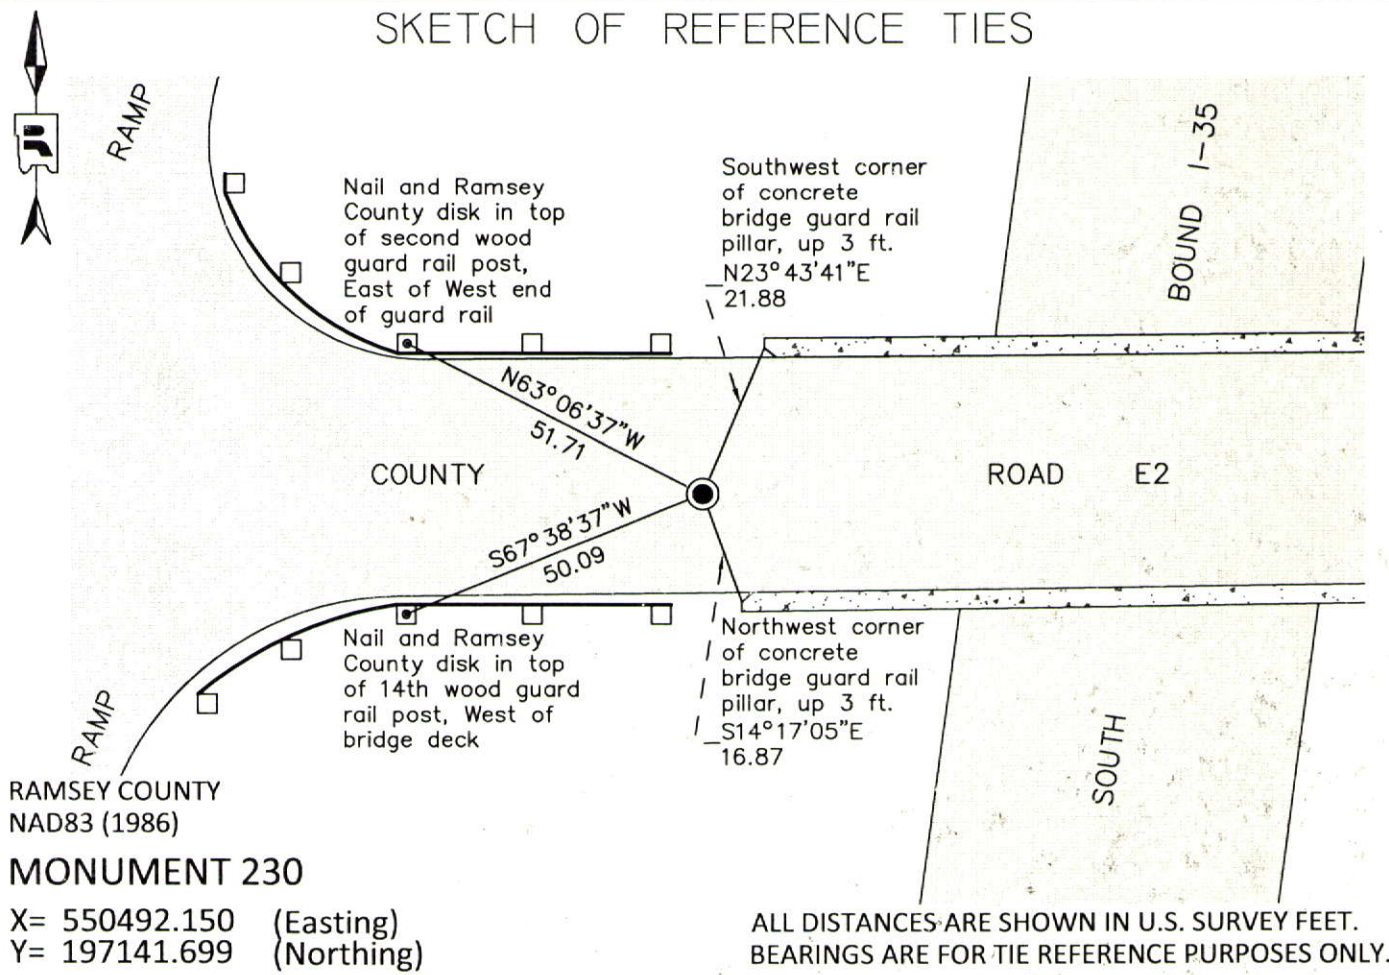

RAMSEY COUNTY  
NAD83 (1986)  
**MONUMENT 230**

X= 550492.150 (Easting)  
Y= 197141.699 (Northing)

ALL DISTANCES ARE SHOWN IN U.S. SURVEY FEET.  
BEARINGS ARE FOR TIE REFERENCE PURPOSES ONLY.

Statements of evidence relative to this corner are on the following page.

I hereby certify that this document was prepared by me or under my direct supervision and that I am a duly Licensed Land Surveyor under the laws of the State of Minnesota.

Daniel D. Baar      12-30-14  
Daniel D. Baar      Date  
Minnesota License No. 45816

- County Surveyor       Land Surveyor  
 Deputy County Surveyor

OFFICE OF COUNTY SURVEYOR  
County of Ramsey

I hereby certify that this document was filed in the County Surveyor's office this 30th day of December, 20 14.

Craig W. Hinzman  
Craig W. Hinzman, L.S.  
Ramsey County Surveyor

# MONUMENT 230

East Quarter Corner of Section 29, Township 30 North, Range 23 West

Set 1/4 Section post, Tamarack 15 N80°W 15, "Do" (Tamarack) 12 S48°E 37, December 16, 1847.

In establishing the 1/4 Corner of between Sections 28 and 29, found two old Government stumps, fixed Corner and tied it, December 22, 1899.

Checked monument, March, 1933.

Checked monument, December, 1943.

Tied cast iron monument, July 21, 1964. (Minnesota Highway Department)

Found a cast iron monument flush and tied, September 24, 1974.

Retied monument, January 9, 1992.

Monument destroyed by bridge work between 1992 and 1997. Checked location on concrete bridge approach, September 23, 1997.

Set a 3-1/2 in. diameter brass disk, October 8, 1997.

Tied monument, June 14, 2002.

Retied monument, July 13, 2007.

Checked 3 in. brass disk monument condition and ties, May 29, 2012.