

MONUMENT 336

CERTIFICATE OF LOCATION OF GOVERNMENT CORNER

East Quarter Corner of Section 1, Township 29 North, Range 23 West, County of Ramsey, State of Minnesota.


At the corner location shown on the sketch

On August 23, 2012 found a cast iron monument with worn top, down 0.25 ft., in bituminous road.

left monument as found raised/lowered monument removed monument (explain)

On _____ placed a _____

SKETCH OF REFERENCE TIES

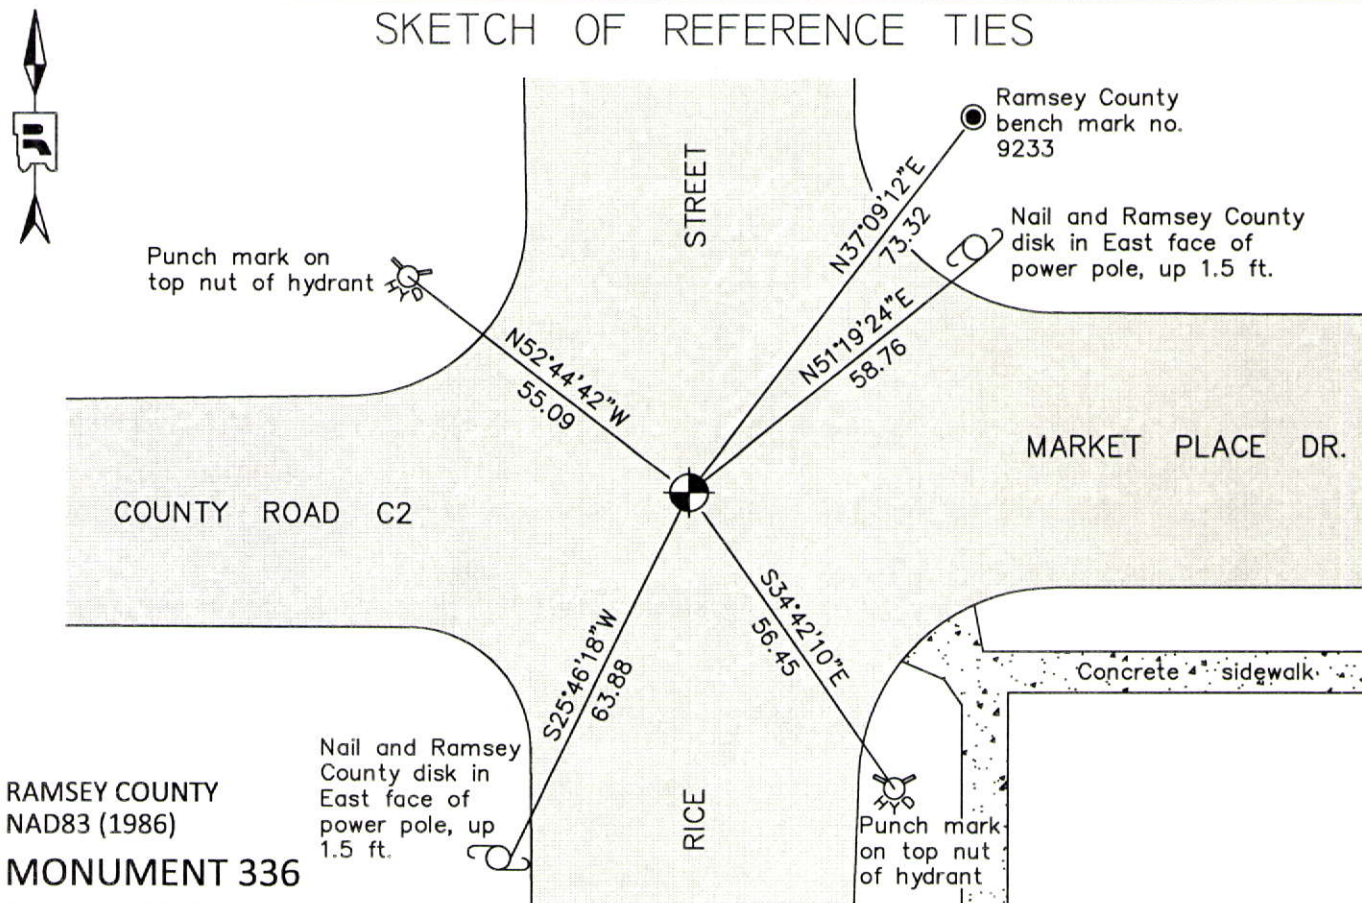

RAMSEY COUNTY
NAD83 (1986)
MONUMENT 336

X= 571673.665 (Easting)
Y= 186481.610 (Northing)

ALL DISTANCES ARE SHOWN IN U.S. SURVEY FEET.
BEARINGS ARE FOR TIE REFERENCE PURPOSES ONLY.

Statements of evidence relative to this corner are on the following page.

I hereby certify that this document was prepared by me or under my direct supervision and that I am a duly Licensed Land Surveyor under the laws of the State of Minnesota.

Daniel D. Baar 12-31-14
Daniel D. Baar Date

Minnesota License No. 45816

- County Surveyor Land Surveyor
 Deputy County Surveyor

OFFICE OF COUNTY SURVEYOR
County of Ramsey

I hereby certify that this document was filed in the County Surveyor's office this 31st day of December, 20 14.

Craig W. Hinzman
Craig W. Hinzman, L.S.
Ramsey County Surveyor

MONUMENT 336

East Quarter Corner of Section 1, Township 29 North, Range 23 West

Set post at qr. Corner, Br. Oak 11 S14°E 33, Br. Oak 8 S32°W 53, October 8, 1847.

In establishing the 1/4 Corner between Section 1, T.29, R.23, and Section 6, T.29, R.22, measured North 2630.20, which checked the line of old fences running East and West. Government witness trees gone. Fixed Corner, tied it, and set monument in June, 1896.

Iron over granite monument, April, 1967.

Found a granite monument down 0.55 ft., June 8, 1976.

Set a short cast iron monument, July 6, 1976.

Checked monument, July 14, 1977.

Tied monument, down 0.25 ft., June 6, 1990.

Retied monument, August 9, 2002.

Retied monument, August 27, 2007.

Found cast iron monument down 0.25 ft. in bituminous road, checked condition of ties, August 23, 2012.