

# MONUMENT 355

## CERTIFICATE OF LOCATION OF GOVERNMENT CORNER

Northeast Corner of Section 10, Township 29 North, Range 23 West, County of Ramsey, State of Minnesota.


At the corner location shown on the sketch

On July 6, 2011 found a cast iron monument within a cast iron manhole assembly.

left monument as found       raised/lowered monument       removed monument (explain)

On \_\_\_\_\_ placed a \_\_\_\_\_

### SKETCH OF REFERENCE TIES

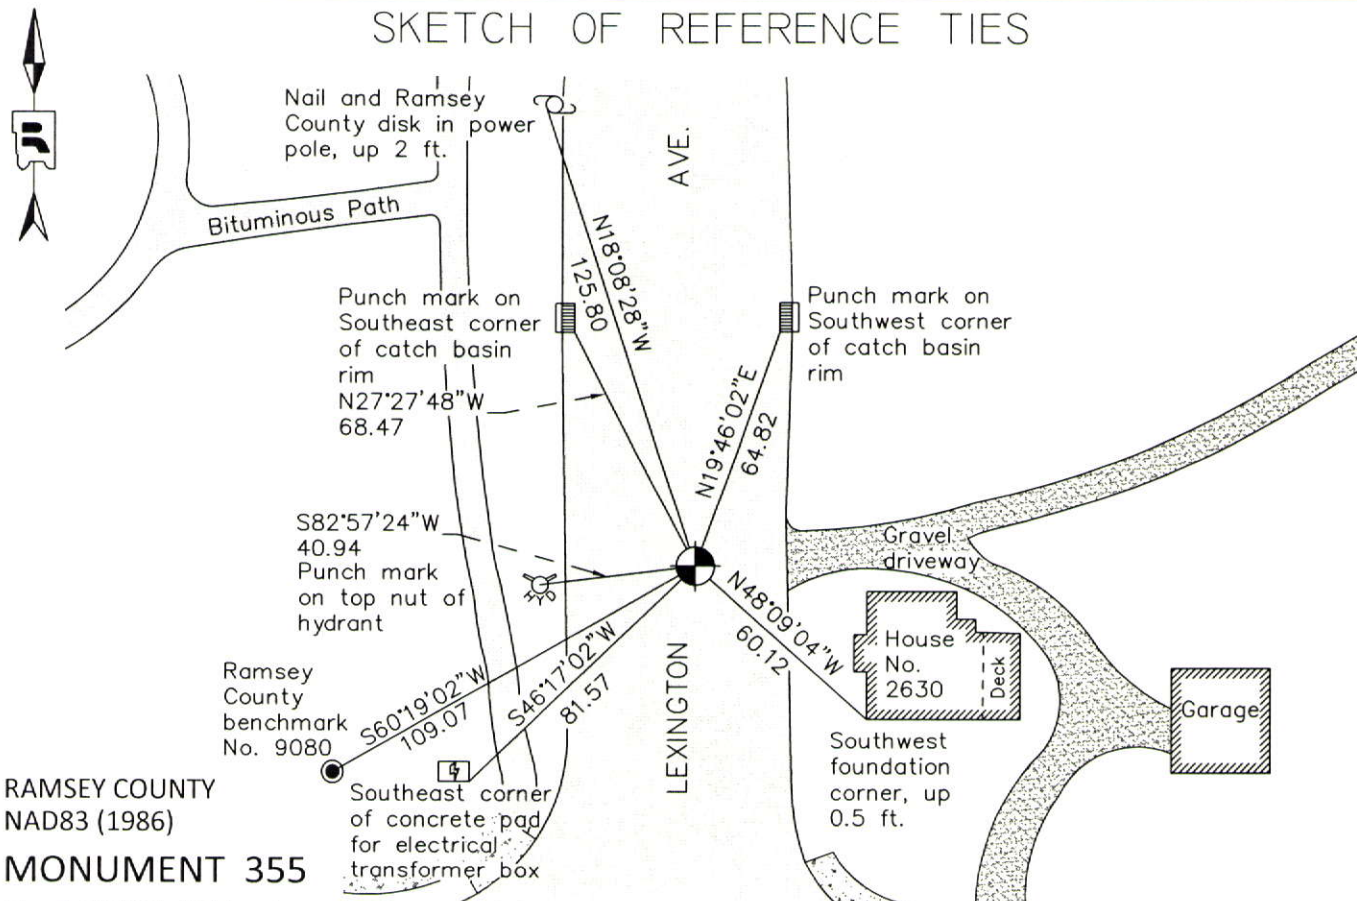

RAMSEY COUNTY  
NAD83 (1986)  
**MONUMENT 355**

X= 561192.487 (Easting)  
Y= 183799.312 (Northing)

ALL DISTANCES ARE SHOWN IN U.S. SURVEY FEET.  
BEARINGS ARE FOR TIE REFERENCE PURPOSES ONLY.

Statements of evidence relative to this corner are on the following page.

I hereby certify that this document was prepared by me or under my direct supervision and that I am a duly Licensed Land Surveyor under the laws of the State of Minnesota.

Daniel D. Baar      12-30-14  
Daniel D. Baar      Date  
Minnesota License No. 45816

- County Surveyor       Deputy County Surveyor       Land Surveyor

OFFICE OF COUNTY SURVEYOR  
County of Ramsey

I hereby certify that this document was filed in the County Surveyor's office this 30th day of December, 20 14.

Craig W. Hinzman  
Craig W. Hinzman, L.S.  
Ramsey County Surveyor

# MONUMENT 355

Northeast Corner of Section 10, Township 29 North, Range 23 West

Set Post Corner to Sections 2, 3, 10, & 11, B. Oak 15 N89°W 26, W. Oak 12 S38°E 85, November 03, 1847.

The Northeast Corner of Section 10 found iron stake which had been there for about 10 years, no Witness trees, set monument, May 1896.

Found a cast iron monument flush and tied, July 29, 1974.

Monument destroyed during construction; set a 20 in. cast iron monument, September, 1980.

Tied monument and set 20 in. cast iron monument 1.5 ft. below grade, April 30 and May 1, 1998.

Set cast iron manhole assembly over monument, July 23, 1998.

Retied monument, December 1, 1998.

Retied monument, June 28, 2006.

Retied cast iron monument within a cast iron manhole assembly, July 6, 2011.