

MONUMENT 574


CERTIFICATE OF LOCATION OF GOVERNMENT CORNER

East Quarter Corner of Section 34, Township 29 North, Range 22 West, County of Ramsey, State of Minnesota.

At the corner location shown on the sketch

- On May 23, 2016 found a cast iron monument. Offset monument for removal during
planned future road reconstruction. Monument removed by others.
- left monument as found
 raised/lowered monument
 removed monument (explain)
- On June 2, 2017 placed a 20 inch "Ramsey County" cast iron monument within manhole
assembly. Manhole assembly set by contractor.

SKETCH OF REFERENCE TIES

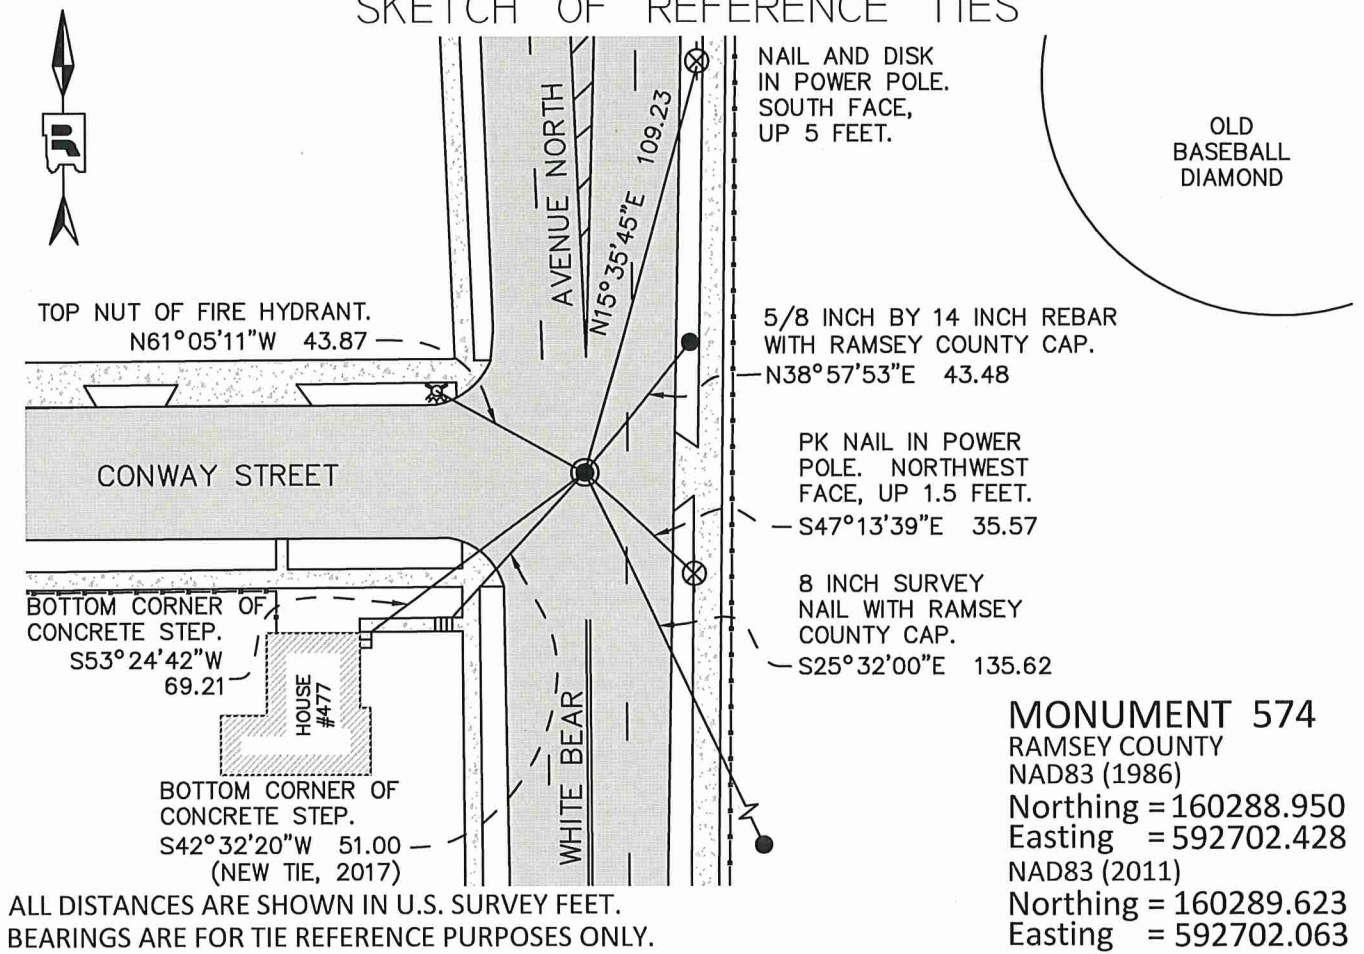

Statements of evidence relative to this corner are on the following page.

I hereby certify that this survey, plan, or report was prepared by me or under my direct supervision, that I am a duly Licensed Land Surveyor under the laws of the state of Minnesota, and that this certificate is correct and complete to the best of my knowledge and belief.

Daniel D. Baar 4/1/21
 Daniel D. Baar Date
 Deputy County Surveyor
 Minnesota License No. 45816

OFFICE OF COUNTY SURVEYOR
 County of Ramsey

I hereby certify that this document was filed in the County Surveyor's office this 1st day of April, 2021.

Daniel D. Baar
 Daniel D. Baar, L.S.
 Ramsey County Surveyor

MONUMENT 574

East Quarter Corner of Section 34, Township 29 North, Range 22 West

- Nov. 25, 1847 North between Sections 34 and 35, at 40.00 chains, Set a 1/4 Section post. Bur Oak 10 N88E 1.45 and Bur Oak 8 N81W 82. Isaac Higbee, Deputy Surveyor.
- January 14, 1891 Monument set by J.H. Armstrong. City of St Paul.
- March 5, 1987 Found granite monument at grade. City of St Paul.
- May 3, 1995 Granite monument removed for street reconstruction. City of St. Paul
- August 24, 1995 Cast iron monument set to grade. City of St Paul
- June 1, 2015 Set monument offsets to cast iron monument prior to removal for upcoming road construction. Ramsey County Surveyor's Office.
- May 23, 2016 Previous monument offsets destroyed/lost. Set new monuments offsets for upcoming road construction. Ramsey County Surveyor's Office.
- Summer, 2017 Cast iron monument removed by contractor due to road construction. Exact date unknown. Ramsey County Surveyor's Office.
- June 2, 2017 Placed a 20 inch "Ramsey County" cast iron monument and tied. Manhole assembly was placed over monument by contractor. Ramsey County Surveyor's Office.