

MONUMENT 120


CERTIFICATE OF LOCATION OF GOVERNMENT CORNER

North Quarter Corner of Section 15, Township 30 North, Range 22 West, County of Ramsey, State of Minnesota.

At the corner location shown on the sketch

- On September 6, 2012 found a cast iron monument, flush in bituminous road; tied for removal during road reconstruction.
- left monument as found
 raised/lowered monument
 removed monument (explain)
- On September 21, 2012 placed a "Ramsey County" cast iron monument within a cast iron manhole assembly.

SKETCH OF REFERENCE TIES

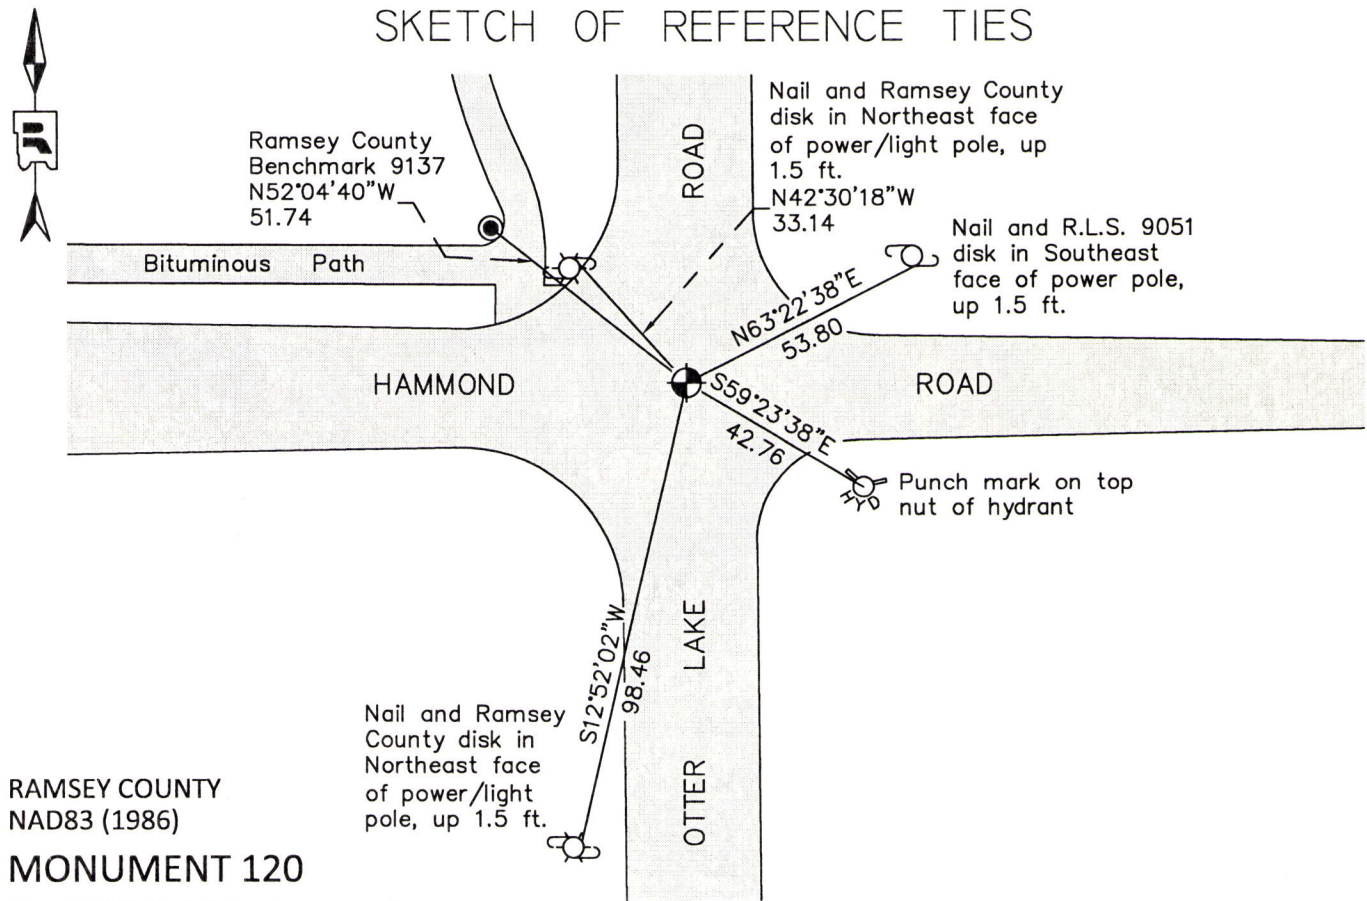

RAMSEY COUNTY
NAD83 (1986)
MONUMENT 120

X= 589748.140 (Easting)
Y= 210548.368 (Northing)

ALL DISTANCES ARE SHOWN IN U.S. SURVEY FEET.
BEARINGS ARE FOR TIE REFERENCE PURPOSES ONLY.

Statements of evidence relative to this corner are on the following page.

I hereby certify that this document was prepared by me or under my direct supervision and that I am a duly Licensed Land Surveyor under the laws of the State of Minnesota.

Daniel D. Baar 11-20-14
Daniel D. Baar Date
Minnesota License No. 45816

- County Surveyor
 Land Surveyor
 Deputy County Surveyor

OFFICE OF COUNTY SURVEYOR
County of Ramsey

I hereby certify that this document was filed in the County Surveyor's office this 20th day of November, 20 14.

Craig W. Hinzman
Craig W. Hinzman, L.S.
Ramsey County Surveyor

MONUMENT 120

North Quarter Corner of Section 15, Township 30 North, Range 22 West

Set 1/4 Section post, W. Oak 14 S85°E 188, B. Oak 8 N52°W 1.10,
December 2, 1847.

In establishing the 1/4 Corner between Sections 10 and 15, found old boulder monument at 1/4 Corner and one Government witness tree and one stump. Retied and set monument, October 13, 1896.

Reset monument using ties, November 2, 1937.

Checked monument, October, 1939.

Found a granite monument, down 0.3 ft.; placed a cast iron cap and bolt monument and cemented into place, May 21, 1974.

Tied monument, June 20, 1974.

Removed cast iron cap and bolt during sewer construction; replaced with a 20 in. cast iron monument, May 7, 1979.

Tied monument, down 0.2 ft., September 21, 1989.

Retied monument, September 30, 1999.

Retied monument, September 24, 2004.

Retied monument, October 13, 2009.

Tied monument for removal during road reconstruction, September 6, 2012.

Set new "Ramsey County" 20 in. cast iron monument in a cast iron manhole assembly using construction ties. Tied monument, September 21, 2012.