

# MONUMENT 134

## CERTIFICATE OF LOCATION OF GOVERNMENT CORNER

East Quarter Corner of Section 15, Township 30 North, Range 23 West, County of Ramsey, State of Minnesota.


At the corner location shown on the sketch

On August 15, 2012 found a "Ramsey County" cast iron monument within a cast iron manhole assembly.

left monument as found     
  raised/lowered monument     
  removed monument (explain)

On \_\_\_\_\_ placed a \_\_\_\_\_

### SKETCH OF REFERENCE TIES

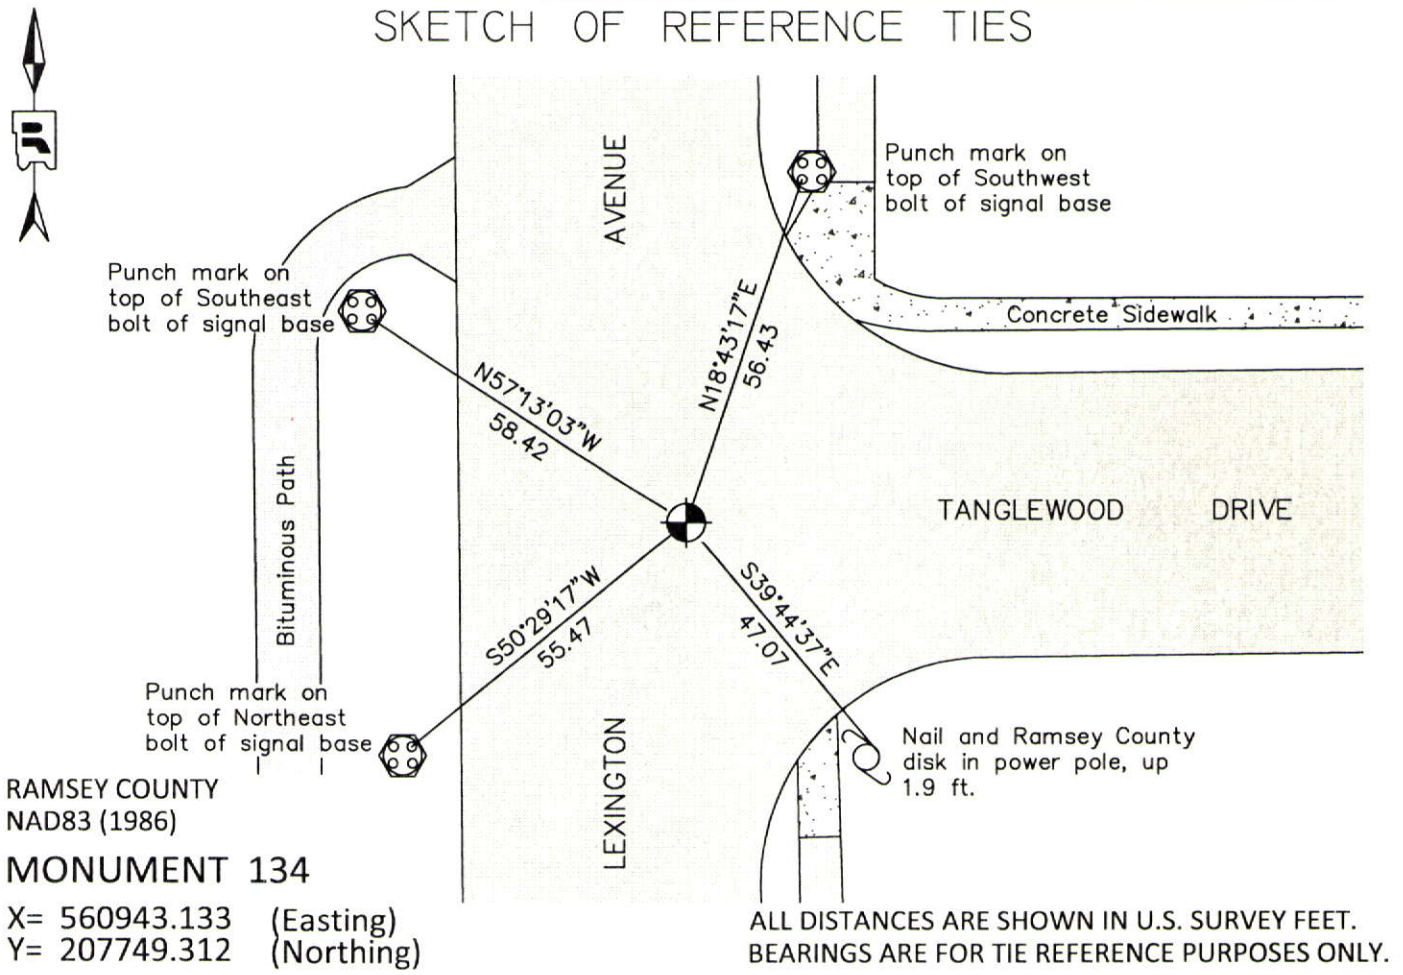

Statements of evidence relative to this corner are on the following page.

I hereby certify that this document was prepared by me or under my direct supervision and that I am a duly Licensed Land Surveyor under the laws of the State of Minnesota.

Daniel D. Baar      12-30-14  
Daniel D. Baar      Date  
Minnesota License No. 45816

- County Surveyor       Land Surveyor  
 Deputy County Surveyor

OFFICE OF COUNTY SURVEYOR  
County of Ramsey

I hereby certify that this document was filed in the County Surveyor's office this 30th day of December, 20 14.

Craig W. Hinzman  
Craig W. Hinzman, L.S.  
Ramsey County Surveyor

# MONUMENT 134

East Quarter Corner of Section 15, Township 30 North, Range 23 West

Set 1/4 Section post, Tamarack 13 S64°W 46, "Do" (Tamarack) 10 N46°W 15, December 16, 1847.

In establishing the 1/4 Corner between Sections 14 and 15, found one Gov. witness stump. Fixed Corner and set Monument, May, 1897.

Checked granite monument with bolt over it, November, 1943.

Checked granite monument with bolt, March, 1952.

Checked granite monument with bolt, February, 1954.

Checked granite monument with bolt, March, 1968.

Found iron in concrete; granite monument down 0.24 ft.; placed a bolt and cast iron cap monument, July 17, 1975.

Tied monument, July 28, 1975.

Removed monument for reconstruction of Lexington Avenue, no date given in field book.

Reset monument, no date given in field book.

Tied monument, May 4, 1990.

Cemented around top of monument, October 1, 1997.

Cemented around top of monument, June 8, 2000.

Retied monument, March 20, 2001.

Removed and lowered cast iron monument; set a 12 in. tube around monument for road maintenance, April 30, 2002.

Found a cast iron monument within a cast iron manhole assembly and tied out, July 19, 2007.

# MONUMENT 134

East Quarter Corner of Section 15, Township 30 North, Range 23 West

Checked condition of cast iron monument within a cast iron manhole assembly and ties, August 15, 2012.