

MONUMENT 147

CERTIFICATE OF LOCATION OF SECTION SUBDIVISION MONUMENT

Center of Section 14, Township 30 North, Range 22 West, County of Ramsey, State of Minnesota.


At the corner location shown on the sketch

On September 16, 2011 found cast iron monument within a cast iron manhole assembly.

left monument as found raised/lowered monument removed monument (explain)

On _____ placed a _____

SKETCH OF REFERENCE TIES

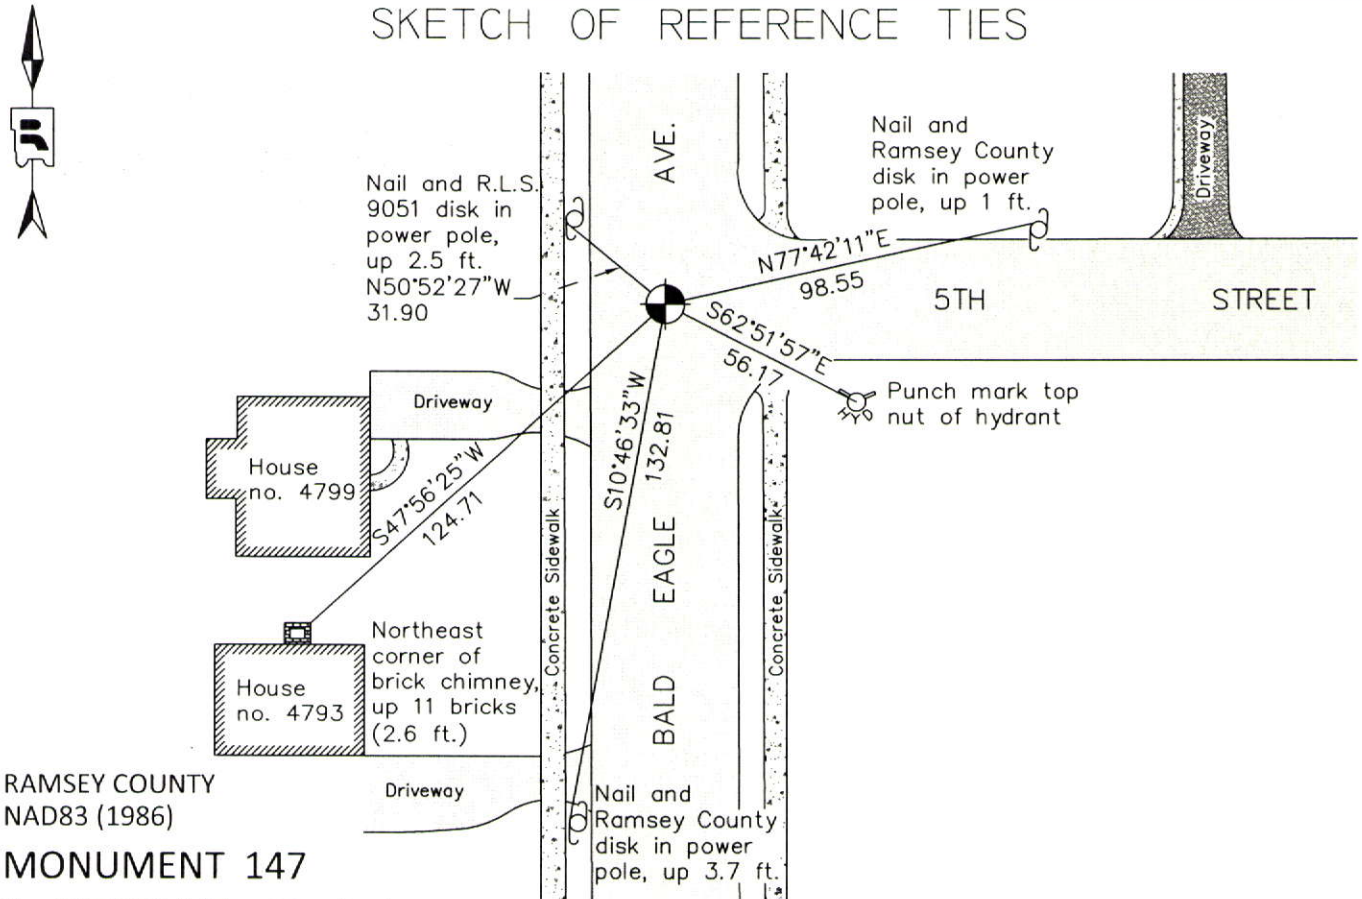

RAMSEY COUNTY
NAD83 (1986)

MONUMENT 147

X= 595036.047 (Easting)
Y= 207901.744 (Northing)

ALL DISTANCES ARE SHOWN IN U.S. SURVEY FEET.
BEARINGS ARE FOR TIE REFERENCE PURPOSES ONLY.

Statements of evidence relative to this corner are on the following page.

I hereby certify that this document was prepared by me or under my direct supervision and that I am a duly Licensed Land Surveyor under the laws of the State of Minnesota.

Daniel D. Baar 12-30-14
Daniel D. Baar Date
Minnesota License No. 45816

- County Surveyor Land Surveyor
 Deputy County Surveyor

OFFICE OF COUNTY SURVEYOR
County of Ramsey

I hereby certify that this document was filed in the County Surveyor's office this 30th day of December, 20 14.

Craig W. Hinzman
Craig W. Hinzman, L.S.
Ramsey County Surveyor

MONUMENT 147

Center of Section 14, Township 30 North, Range 22 West

Set monument at Center of Section 14 by Intersection, November 14, 1896.

Stone monument shown at this location on SPRUCE GROVE plat, January 3, 1924.

Checked monument, October, 1939.

Found a granite monument, down 0.1 ft., May 21, 1974.

Tied monument, October 10, 1974.

Found a cast iron monument, down +/-0.1 ft. and retied, January 24, 1992.

Tied out monument for removal by the city, August 1, 1995.

Relocated position and set P.K. nails, July 23, 1996.

Set a 20 in. cast iron monument, down 18 in., within a cast iron manhole assembly, March 30, 1999.

Tied monument, September 23, 1999.

Retied monument, November 15, 2004.

Tied out monument for removal during sewer construction, August 23, 2006.

Reset a 20 in. cast iron monument within a manhole assembly, July 16, 2007.

Retied a cast iron monument within a cast iron manhole assembly, September 16, 2011.