

MONUMENT 153W

CERTIFICATE OF LOCATION OF GOVERNMENT CORNER

Witness Monument to the West of the Southeast Corner of Section 18,
Township 30 North, Range 23 West, County of Ramsey, State of Minnesota.


At the corner location shown on the sketch

On April 26, 2007 found a cast iron monument, flush.

left monument as found lowered monument removed monument (explain)

On _____ placed a _____

SKETCH OF REFERENCE TIES

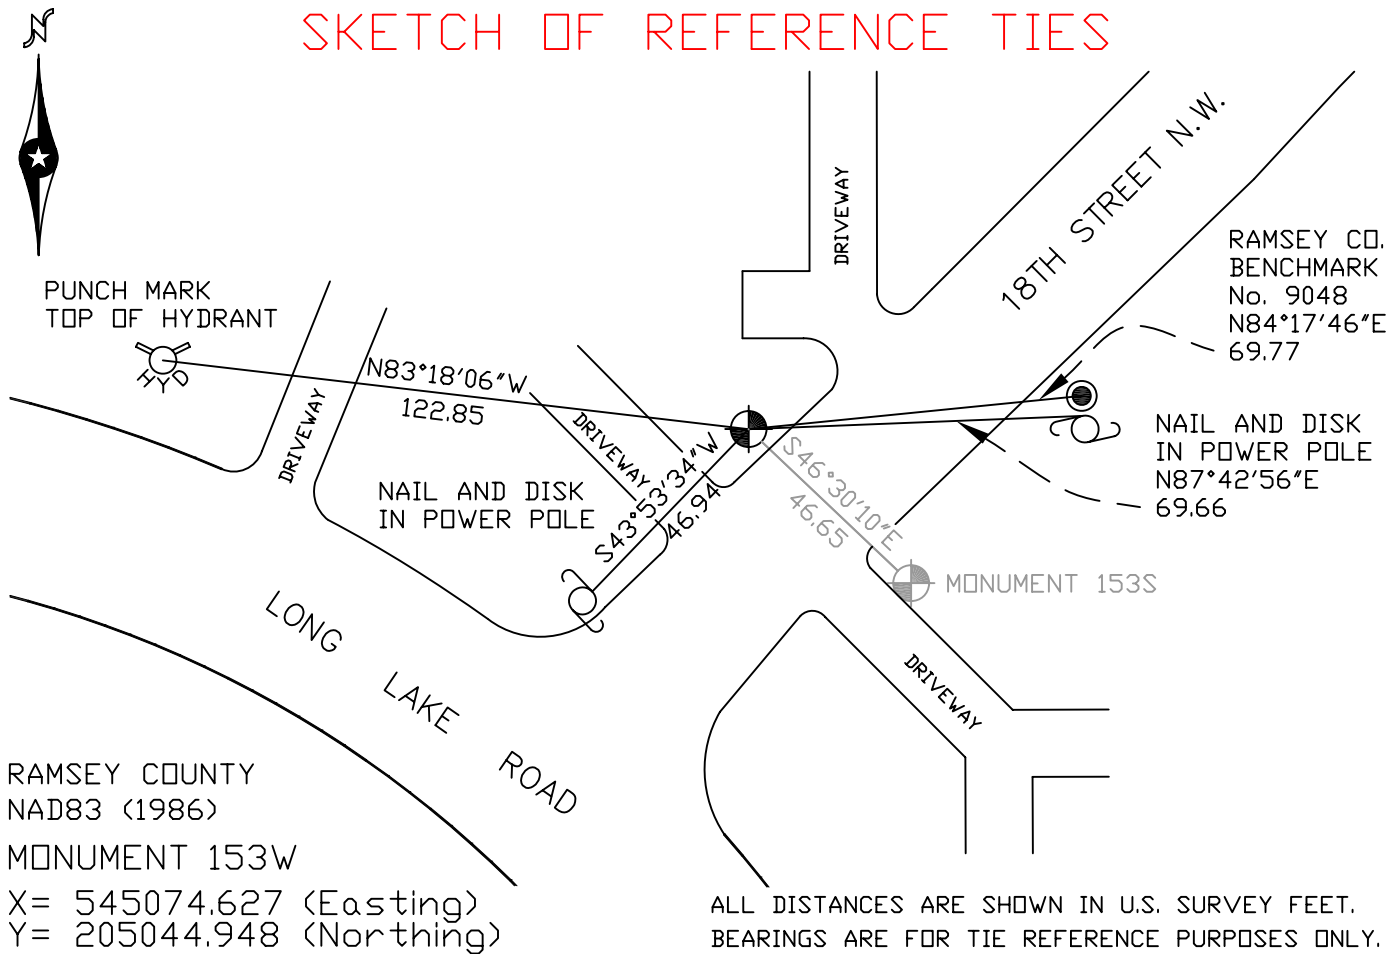

Statements of evidence relative to this corner are on the following page(s).

I hereby certify that this document and the data contained herein was prepared by me or under my direct supervision this _____ day of _____, 20____.

SIGNATURE

Minnesota License No. _____

- County Surveyor
 Deputy County Surveyor Land Surveyor

OFFICE OF COUNTY SURVEYOR

County of Ramsey

I hereby certify that this document was filed in the County Surveyor's office on the ____ day of _____, 20____.

David D. Claypool, P.L.S., County Surveyor

By _____, Deputy

MONUMENT 153W

Found a manhole at corner location. Old ties mostly gone. See Survey Book No. 1, pages 60 and 61 for location determination. No date given in field book.

Retied monument, January 28, 1975.

Placed cast iron witness corner monument 33 ft. west of the true corner position and on line, October 30, 1975.

Removed cast iron monument for reconstruction, April, 1989.

Replaced corner position with 20 in. cast iron monument, July 3, 1990.

Retied monument, July 5, 1990.

Retied monument, December 2, 1998.

Found witness corner cast iron monument laying on its side; reestablished monument position from ties; reset 20 in. cast iron monument; retied monument, November 15, 2004.

Retied monument, April 26, 2007.