

# MONUMENT 186E

## CERTIFICATE OF LOCATION OF GOVERNMENT CORNER

Monument on the East-West Quarter line of Section 24, Township 30 North,  
Range 23 West, County of Ramsey, State of Minnesota.


At the corner location shown on the sketch

On April 19, 2008 found a granite monument.

left monument as found     lowered monument     removed monument (explain)

On \_\_\_\_\_ placed a \_\_\_\_\_

## SKETCH OF REFERENCE TIES

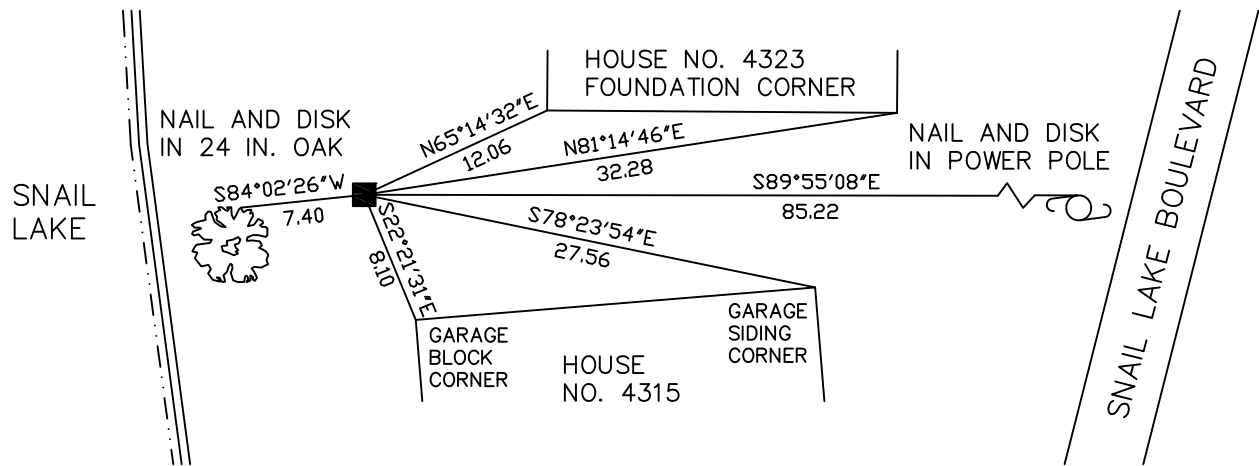

RAMSEY COUNTY  
NAD83 (1986)  
MONUMENT 186E

X= 568024.385 (Easting)  
Y= 202524.528 (Northing)

ALL DISTANCES ARE SHOWN IN U.S. SURVEY FEET.  
BEARINGS ARE FOR TIE REFERENCE PURPOSES ONLY.

Statements of evidence relative to this corner are on the following page(s).

I hereby certify that this document and the data contained herein was prepared by me or under my direct supervision this \_\_\_\_\_ day of \_\_\_\_\_, 20\_\_\_\_.

SIGNATURE

Minnesota License No. \_\_\_\_\_

- County Surveyor  
 Deputy County Surveyor     Land Surveyor

OFFICE OF COUNTY SURVEYOR  
County of Ramsey

I hereby certify that this document was filed in the County Surveyor's office on the \_\_\_\_ day of \_\_\_\_\_, 20\_\_\_\_.

David D. Claypool, P.L.S., County Surveyor

By \_\_\_\_\_, Deputy

# MONUMENT 186E

Found a granite monument, September 30, 1987.

Retied monument, up +/- 6 in., June 5, 1990.

Retied monument, up +/- 6 in., November 25, 2002.

Retied monument, April 19, 2008.