

MONUMENT 18E

CERTIFICATE OF LOCATION OF GOVERNMENT CORNER

Meander Corner No. 19, Section 4, Township 30 North, Range 22 West, County of Ramsey, State of Minnesota.


At the corner location shown on the sketch

On November 4, 2009 found a granite monument, down +/-3 feet.

left monument as found lowered monument removed monument (explain)

On _____ placed a _____

SKETCH OF REFERENCE TIES

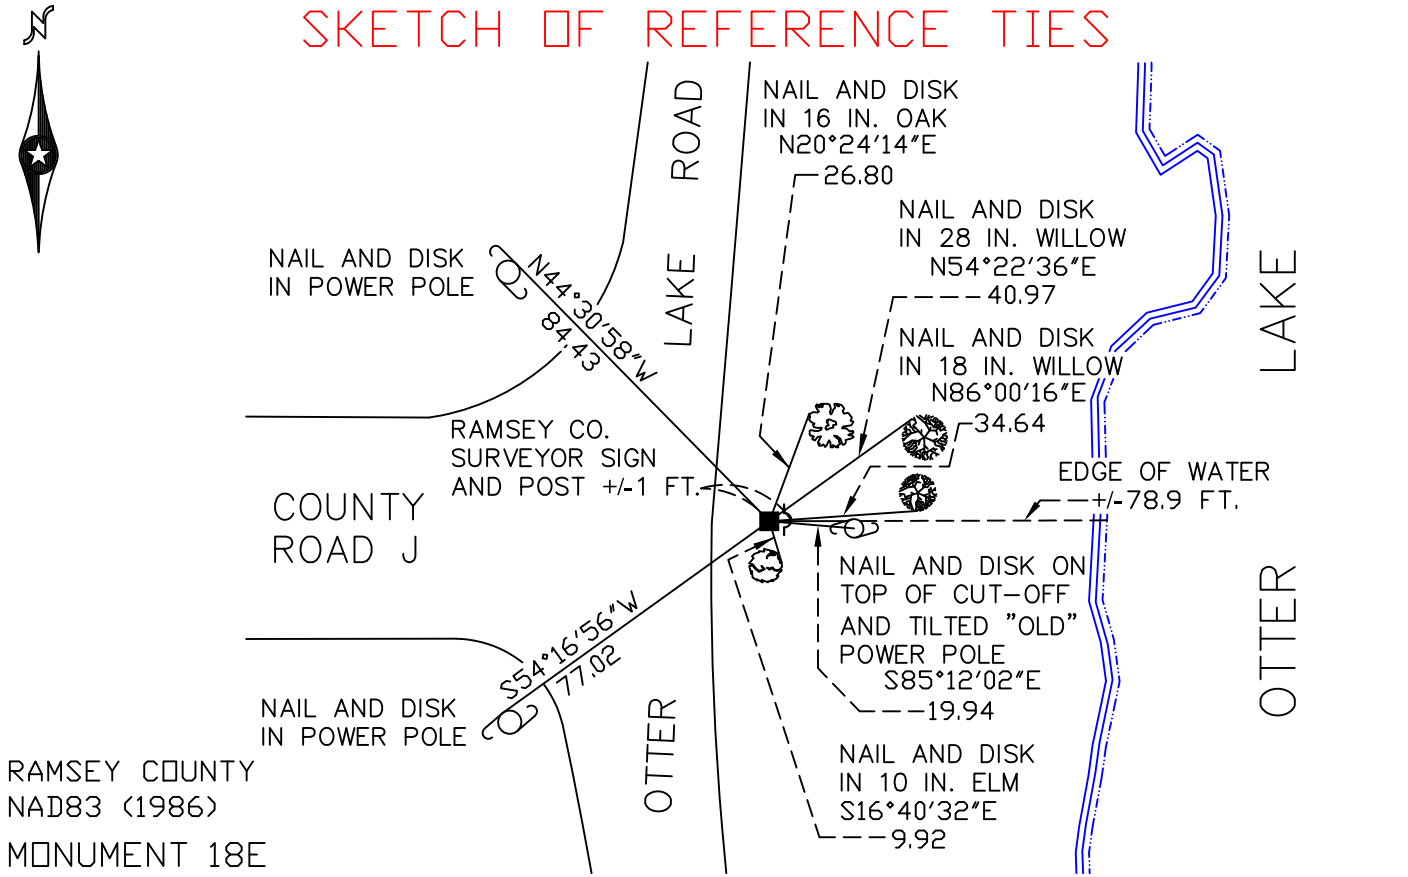

RAMSEY COUNTY
NAD83 (1986)
MONUMENT 18E

X= 586605.260 (Easting)
Y= 221541.775 (Northing)

ALL DISTANCES ARE SHOWN IN U.S. SURVEY FEET.
BEARINGS ARE FOR TIE REFERENCE PURPOSES ONLY.

Statements of evidence relative to this corner are on the following page(s).

I hereby certify that this document and the data contained herein was prepared by me or under my direct supervision this _____ day of _____, 20____.

SIGNATURE

Minnesota License No. _____

County Surveyor
 Deputy County Surveyor Land Surveyor

OFFICE OF COUNTY SURVEYOR
County of Ramsey

I hereby certify that this document was filed in the County Surveyor's office on the _____ day of _____, 20____.

SIGNATURE

Michael D. Fiebiger, P.L.S.
Ramsey County Surveyor

MONUMENT 18E

Found a granite monument, down 0.2 ft., May 15, 1974.

Retied monument, July 3, 1974.

Ties gone or tilted; monument down +/- 3 ft., June 15, 1998.

Retied monument, December 16, 2004.

Retied monument, down +/- 3 ft., set sign and post 1 ft. east, November 4, 2009.