

MONUMENT 206

CERTIFICATE OF LOCATION OF GOVERNMENT CORNER

North Quarter Corner of Section 28, Township 30 North, Range 23 West, County of Ramsey, State of Minnesota.


At the corner location shown on the sketch

On May 29, 2012 found a 3 inch diameter brass disk, stamped "RAMSEY COUNTY", flush in gutter of concrete curb.

left monument as found raised/lowered monument removed monument (explain)

On _____ placed a _____

SKETCH OF REFERENCE TIES

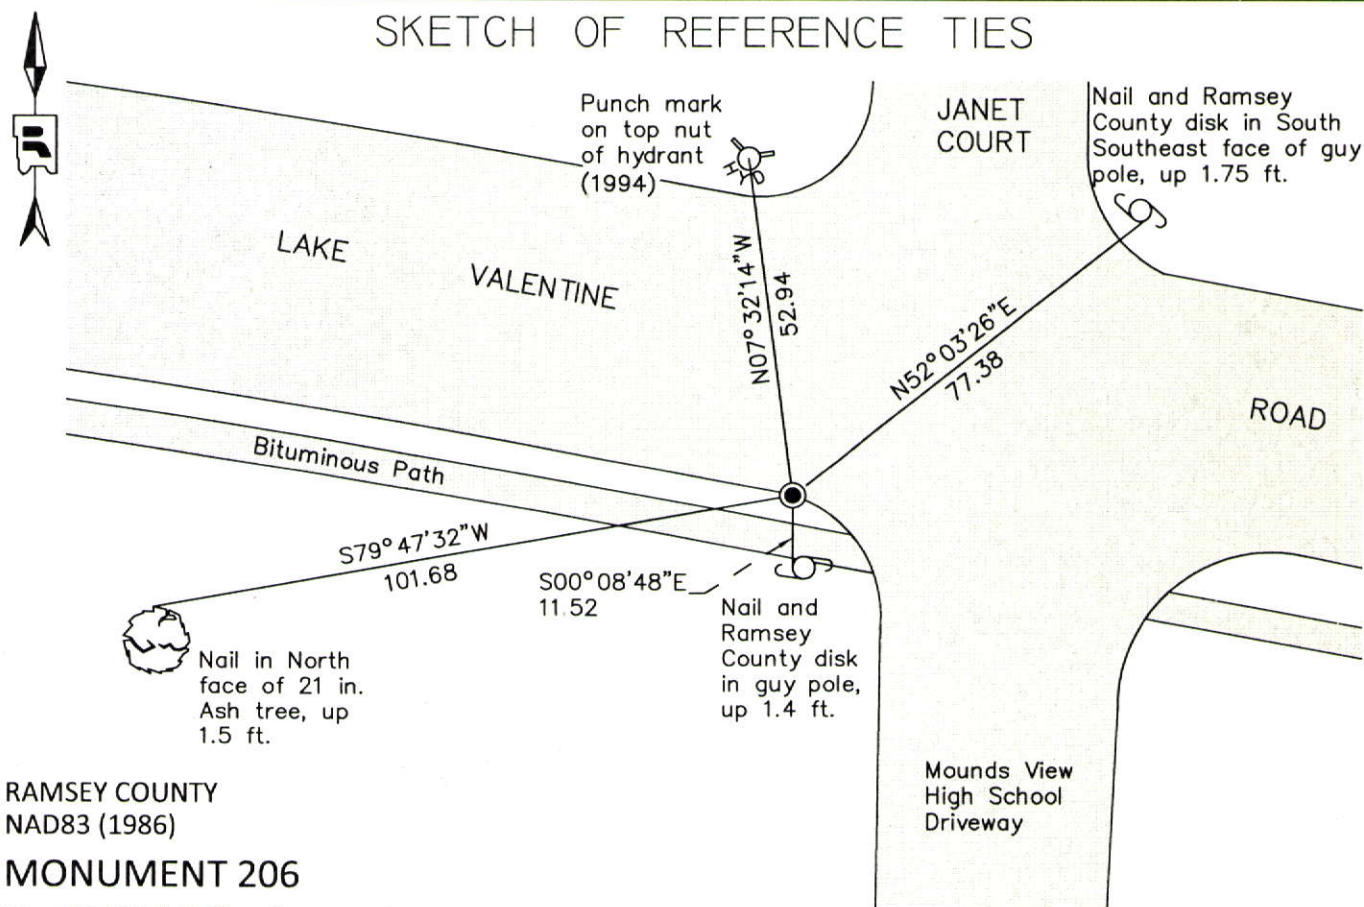

RAMSEY COUNTY
NAD83 (1986)

MONUMENT 206

X= 553080.678 (Easting)
Y= 199820.102 (Northing)

ALL DISTANCES ARE SHOWN IN U.S. SURVEY FEET.
BEARINGS ARE FOR TIE REFERENCE PURPOSES ONLY.

Statements of evidence relative to this corner are on the following page.

I hereby certify that this document was prepared by me or under my direct supervision and that I am a duly Licensed Land Surveyor under the laws of the State of Minnesota.

Daniel D. Baar 12-31-14
Daniel D. Baar Date

Minnesota License No. 45816

- County Surveyor Land Surveyor
 Deputy County Surveyor

OFFICE OF COUNTY SURVEYOR
County of Ramsey

I hereby certify that this document was filed in the County Surveyor's office this 31st day of December, 20 14.

Craig W. Hinzman
Craig W. Hinzman, L.S.
Ramsey County Surveyor

MONUMENT 206

North Quarter Corner of Section 28, Township 30 North, Range 23 West

Set 1/4 Section post, B. Oak 5 N50°W 61, December 16, 1847.

In establishing the 1/4 Corner between Sections 21 and 28, found iron stake at 1/4 Corner and one Government Witness stump. Fixed Corner, tied it and set monument, December, 1895.

Checked monument, December, 1943.

Checked monument, November, 1967.

Ramsey County field notes describe a cast iron monument over granite monument, between December, 1943 and November, 1967.

Found a cast iron monument flush; tied monument, 1975.

Retied monument, down +/-0.4 ft., January 7, 1992.

Tied out monument and removed for construction, July 7, 1995.

Set a 2 1/2 in. brass disk in curb gutter, July 30, 1996.

Tied monument, November 21, 2002.

Retied monument, July 30, 2007.

Checked condition of brass disk monument and ties, May 29, 2012.