

MONUMENT 287

CERTIFICATE OF LOCATION OF GOVERNMENT CORNER

Center of Section 36, Township 30 North, Range 23 West, County of Ramsey,
State of Minnesota.


At the corner location shown on the sketch

On April 1, 2010 found a granite monument, flush.

left monument as found lowered monument removed monument (explain)

On _____ placed a _____

SKETCH OF REFERENCE TIES

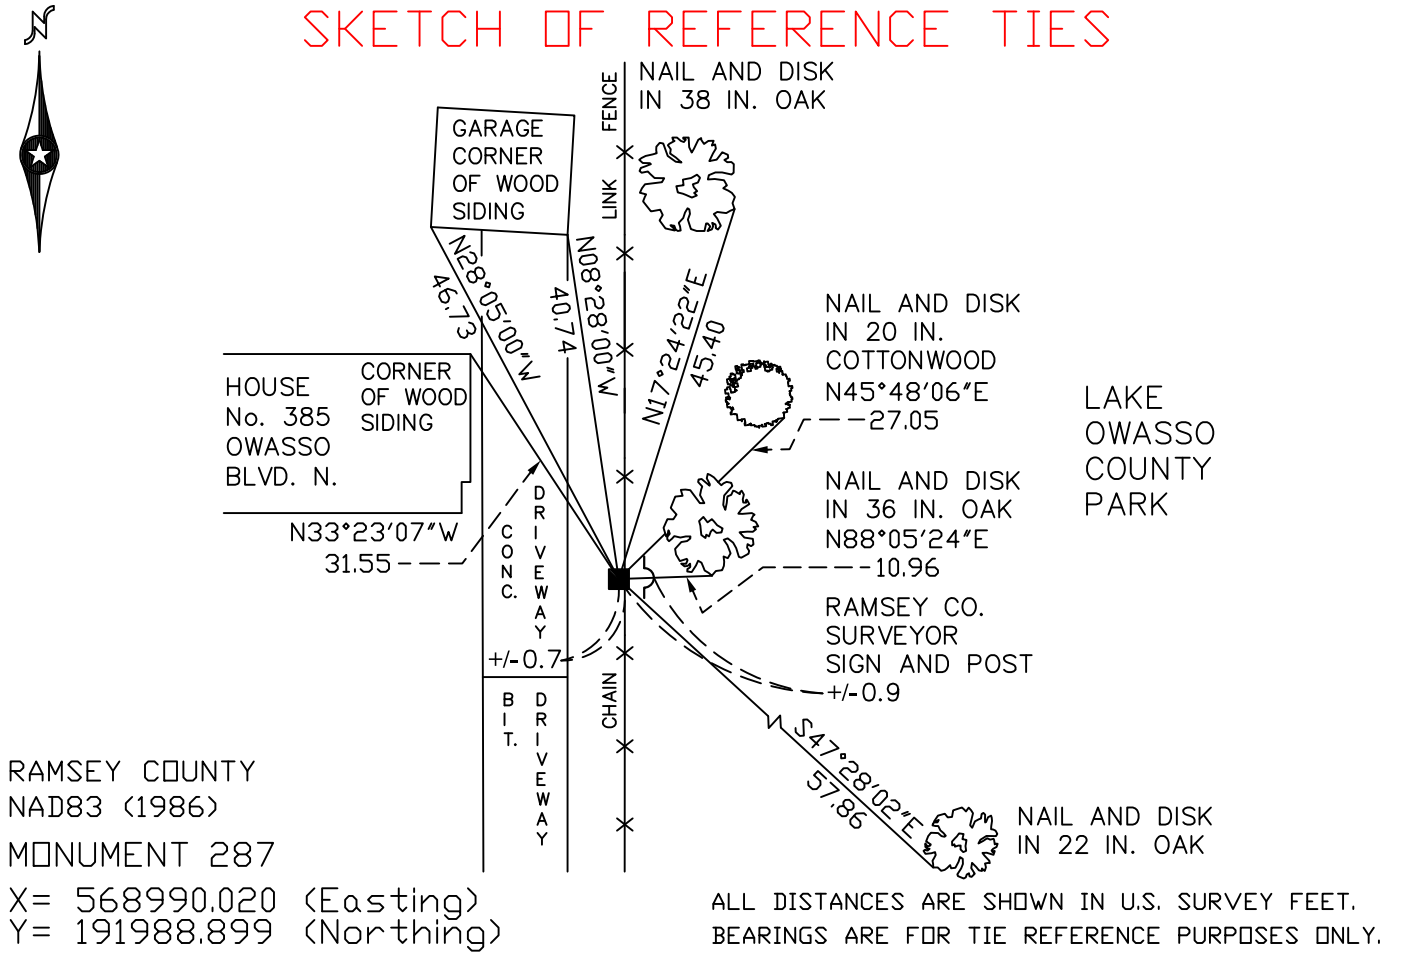

RAMSEY COUNTY
NAD83 (1986)
MONUMENT 287

X= 568990.020 (Easting)
Y= 191988.899 (Northing)

ALL DISTANCES ARE SHOWN IN U.S. SURVEY FEET.
BEARINGS ARE FOR TIE REFERENCE PURPOSES ONLY.

Statements of evidence relative to this corner are on the following page(s).

I hereby certify that this document and the data contained herein was prepared by me or under my direct supervision this _____ day of _____, 20____.

SIGNATURE
Minnesota License No. _____
 County Surveyor
 Deputy County Surveyor Land Surveyor

OFFICE OF COUNTY SURVEYOR
County of Ramsey

I hereby certify that this document was filed in the County Surveyor's office on the _____ day of _____, 20____.

SIGNATURE
Michael D. Fiebiger, P.L.S.
Ramsey County Surveyor

MONUMENT 287

Found a granite monument flush and tied, August 9, 1974.

Retied monument, February 12, 1991.

Retied monument; set a sign and post +/- 1 ft. east, July 8, 2003.

Retied monument, April 1, 2010.