

MONUMENT 300

CERTIFICATE OF LOCATION OF GOVERNMENT CORNER

East Quarter Corner of Section 36, Township 30 North, Range 22 West, County of Ramsey, State of Minnesota.


At the corner location shown on the sketch

On August 10, 2011 found a cast iron monument, flush in concrete median island.

left monument as found raised/lowered monument removed monument (explain)

On _____ placed a _____

SKETCH OF REFERENCE TIES

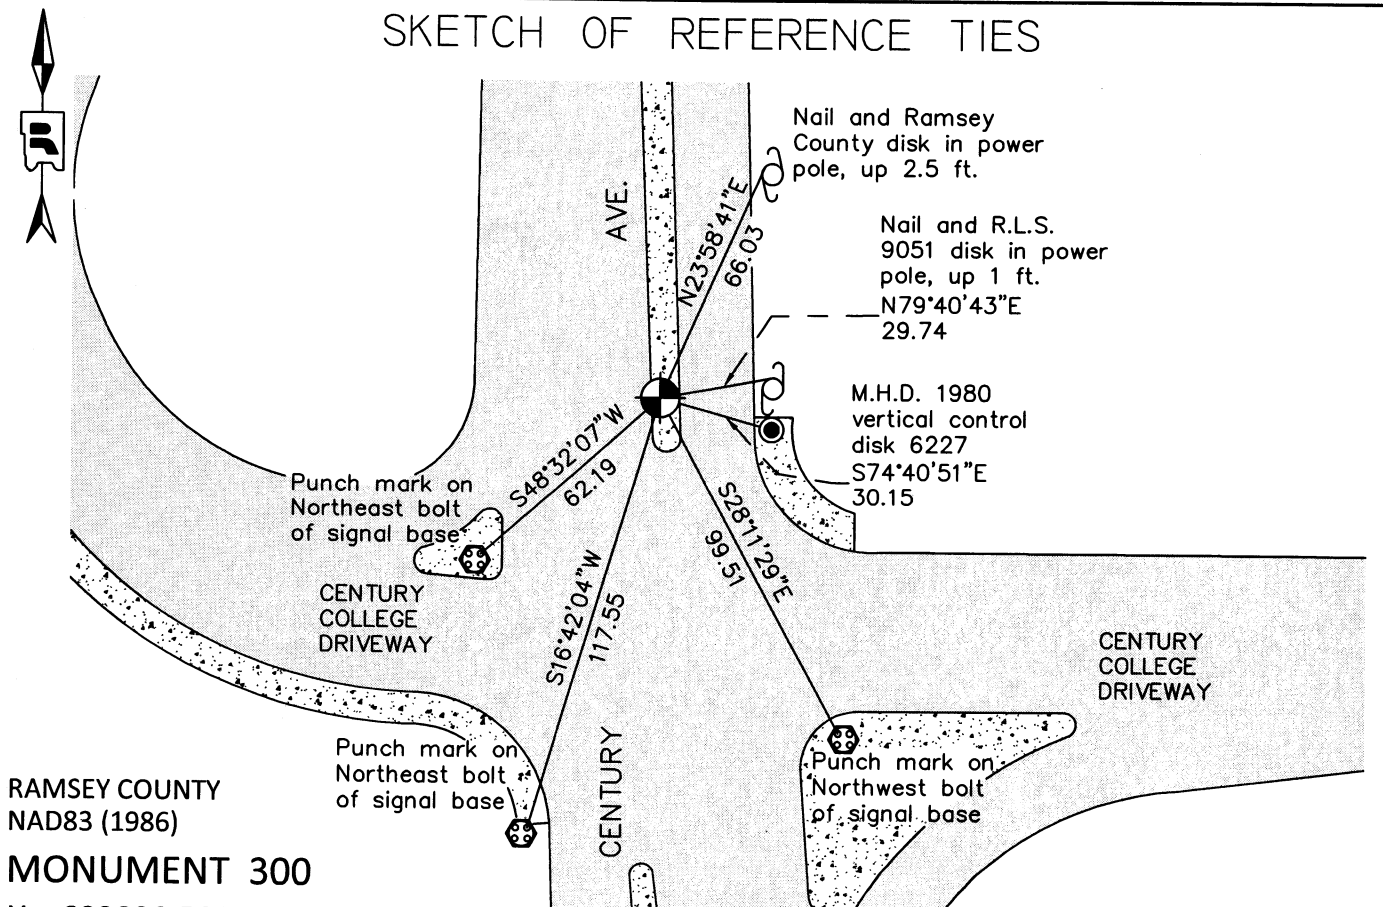

RAMSEY COUNTY
NAD83 (1986)

MONUMENT 300

X= 603030.599 (Easting)
Y= 192102.604 (Northing)

ALL DISTANCES ARE SHOWN IN U.S. SURVEY FEET.
BEARINGS ARE FOR TIE REFERENCE PURPOSES ONLY.

Statements of evidence relative to this corner are on the following page.

I hereby certify that this document was prepared by me or under my direct supervision and that I am a duly Licensed Land Surveyor under the laws of the State of Minnesota.

Daniel D. Baar 9-5-12
Daniel D. Baar Date
Minnesota License No. 45816

- County Surveyor
 Deputy County Surveyor Land Surveyor

OFFICE OF COUNTY SURVEYOR
County of Ramsey

I hereby certify that this document was filed in the County Surveyor's office this 5th day of September, 20 12.

Craig W. Hinzman
Craig W. Hinzman, L.S.
Ramsey County Surveyor

MONUMENT 300

East Quarter Corner of Section 36, Township 30 North, Range 22 West

Set post at qr. Section Corner, B. Oak 10 S30°E 34, B. Oak 10 N60°W 30,
October 19, 1847.

The 1/4 Corner on East side of Section 36, found one Government Witness stump,
fixed Corner, tied it and set Monument, September 25, 1897.

Checked monument, October, 1939.

Tied monument February, 1946.

Found a P.K. nail flush, January 26, 1973. (Washington County Notes)

Found a 2-1/2 solid iron pipe with "X" top center, July 19, 1974. (Washington County
Notes)

Found granite down 1.8 ft; set cast iron monument over granite, July 2, 1976.

Checked monument, June 24, 1977.

Tied monument, November 30, 1982.

Found a cast iron monument on island median as set by Ramsey Co.; Ramsey Co. ties
call for a stone at the corner location, January 25, 1983. (Washington County Notes)

Retied monument, August 8, 1990.

Retied monument, September 23, 1999.

Retied monument, June 26, 2006.

Retied cast iron monument, flush in concrete median island, August 10, 2011.