

# MONUMENT 304

## CERTIFICATE OF LOCATION OF FOUND MONUMENT

North Quarter Corner of Section 5, Township 29 North, Range 23 West, County of Ramsey, State of Minnesota.


At the corner location shown on the sketch

On June 21, 2012 found a "Ramsey County" cast iron monument flush in concrete median.

left monument as found       raised/lowered monument       removed monument (explain)

On \_\_\_\_\_ placed a \_\_\_\_\_

### SKETCH OF REFERENCE TIES

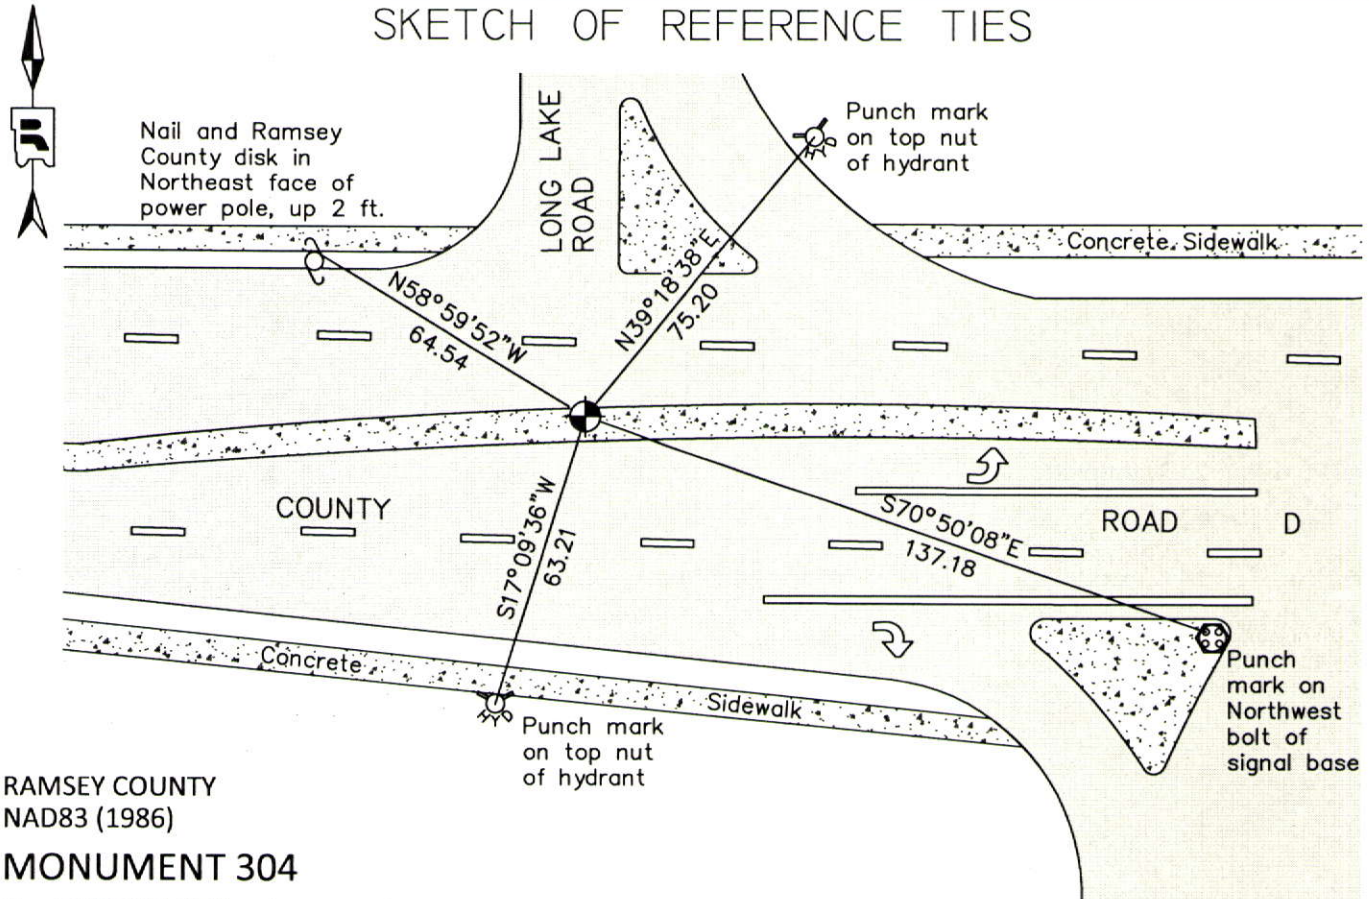

RAMSEY COUNTY  
NAD83 (1986)

### MONUMENT 304

X= 547942.651 (Easting)  
Y= 189247.073 (Northing)

Drafted by: KJ

ALL DISTANCES ARE SHOWN IN U.S. SURVEY FEET.  
BEARINGS ARE FOR TIE REFERENCE PURPOSES ONLY.

Statements of evidence relative to this corner are on the following page.

I hereby certify that this document was prepared by me or under my direct supervision and that I am a duly Licensed Land Surveyor under the laws of the State of Minnesota.

Daniel D. Baar      12-30-14  
Daniel D. Baar      Date  
Minnesota License No. 45816

- County Surveyor       Land Surveyor  
 Deputy County Surveyor

OFFICE OF COUNTY SURVEYOR  
County of Ramsey

I hereby certify that this document was filed in the County Surveyor's office this 30th day of December, 20 14.

Craig W. Hinzman  
Craig W. Hinzman, L.S.  
Ramsey County Surveyor

# MONUMENT 304

North Quarter Corner of Section 5, Township 29 North, Range 23 West

Set post at qr. Section Corner, W. Oak 18 N62°E 279, Br. Oak 10 \*63°W 42, October 17, 1847. \*(Cardinal direction not legible)

In establishing the 1/4 Corner between Section 32, Township 30, Range 23, and Section 5, Township 29, Range 23, found old stake, Government witness trees gone. Fixed Corner and tied it, June 1, 1897.

Set monument, August 4, 1897.

Placed monument, June 22, 1942.

Checked monument, December, 1946.

Checked monument, August, 1965.

Checked monument, December, 1966.

Found a cast iron monument flush and tied, February 13, 1976.

Checked monument, May 9, 1977.

Monument removed for construction of County Road D, no date given in field book.

Replaced with a 20 in. cast iron monument, no date given in field book.

Tied monument, April 23, 1990.

Retied monument, November 13, 2002.

Retied monument, August 2, 2007.

Checked condition of cast iron monument flush in concrete median island and ties, June 21, 2012.