

# MONUMENT 319

## CERTIFICATE OF LOCATION OF GOVERNMENT CORNER

Northeast Corner of Section 4, Township 29 North, Range 22 West, County of Ramsey, State of Minnesota.


At the corner location shown on the sketch

On July 28, 2011 found a cast iron monument, within a cast iron manhole assembly.

left monument as found       raised/lowered monument       removed monument (explain)

On \_\_\_\_\_ placed a \_\_\_\_\_

### SKETCH OF REFERENCE TIES

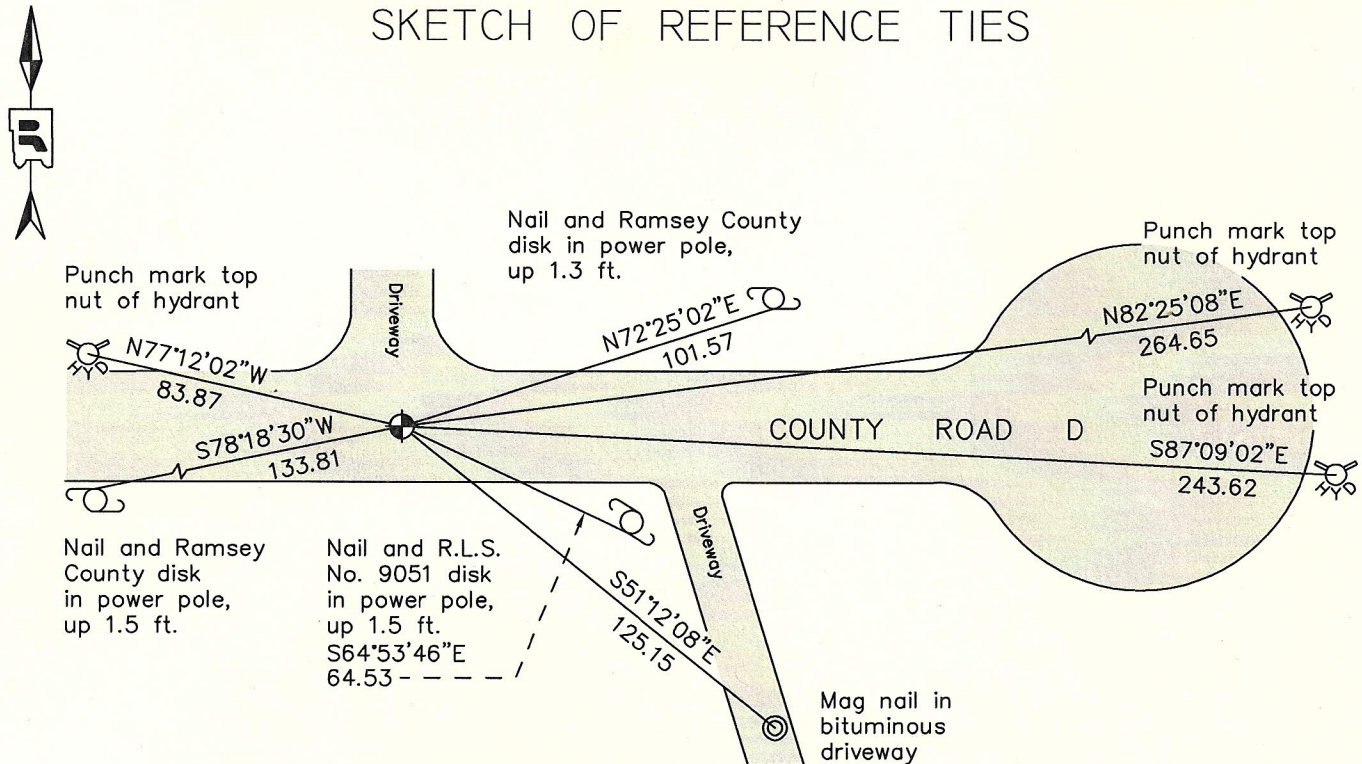

RAMSEY COUNTY  
NAD83 (1986)

### MONUMENT 319

X= 587211.400 (Easting)  
Y= 189414.051 (Northing)

ALL DISTANCES ARE SHOWN IN U.S. SURVEY FEET.  
BEARINGS ARE FOR TIE REFERENCE PURPOSES ONLY.

Statements of evidence relative to this corner are on the following page.

I hereby certify that this document was prepared by me or under my direct supervision and that I am a duly Licensed Land Surveyor under the laws of the State of Minnesota.

Daniel D. Baar      8-15-12  
Daniel D. Baar      Date  
Minnesota License No. 45816

County Surveyor       Land Surveyor  
 Deputy County Surveyor

OFFICE OF COUNTY SURVEYOR  
County of Ramsey

I hereby certify that this document was filed in the County Surveyor's office this 15th day of August, 2012.

Craig W. Hinzman  
Craig W. Hinzman, L.S.  
Ramsey County Surveyor

# MONUMENT 319

Northeast Corner of Section 4, Township 29 North, Range 22 West

Set post at qr. Sec. Corner, Br. Oak 8 S78°W 200, October 15, 1847.

In establishing the Northeast Corner of Section 4, found some old ties, Government Witness trees gone, July 19, 1898.

Set monument August 16, 1898.

Found granite monument down 0.5 ft. and tied, July 9, 1974.

Placed short cast iron over monument, September 18, 1974.

Checked monument, June 24, 1977.

Removed short cast iron, maintenance to remove granite monument, June 4, 1990.

Relocated position and retied, July 16, 1990.

Found granite monument broken off down +/-1 ft., July 20, 1990.

Placed short (4 5/8 in.) cast iron monument, July 25, 1990.

Retied monument, September 21, 1999.

Tied out monument prior to road construction, November 9, 2004.

Replaced monument within a cast iron manhole assembly, August 3, 2006.

Tied monument, August 21, 2006.

Retied a cast iron monument, within a cast iron manhole assembly, July 28, 2011.