

MONUMENT 357N

CERTIFICATE OF LOCATION OF GOVERNMENT CORNER

Witness Monument South of East Quarter Corner of Section 2, Township 29 North, Range 23 West, County of Ramsey, State of Minnesota.


At the corner location shown on the sketch

On June 12, 2012 found a cast iron monument stamped "WITNESS CORNER", down 0.2 ft. in yard.

left monument as found raised/lowered monument removed monument (explain)

On _____ placed a _____

SKETCH OF REFERENCE TIES

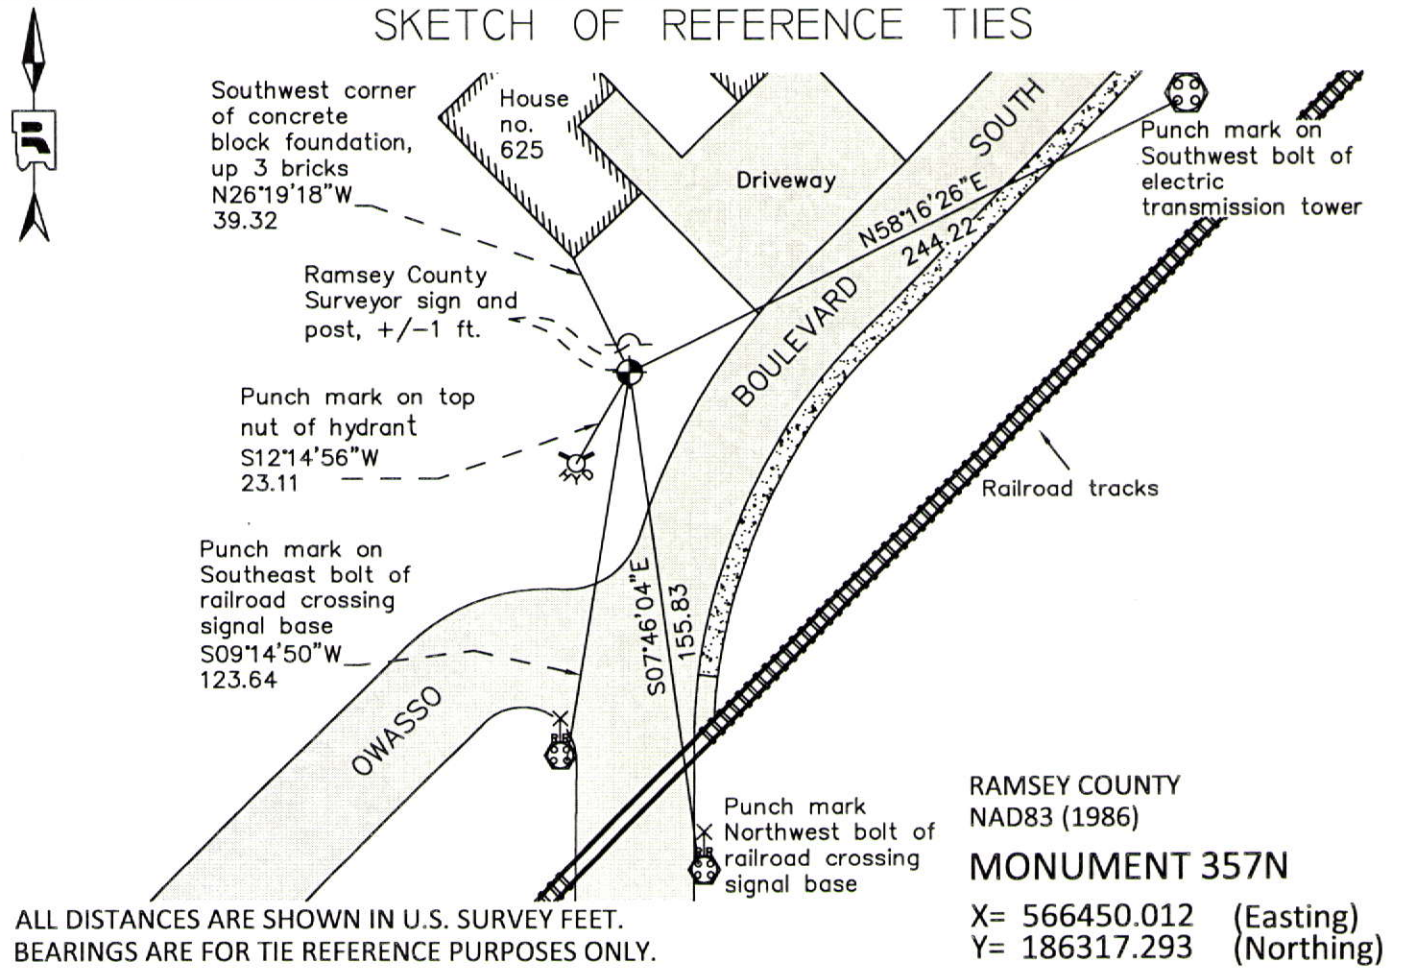

Statements of evidence relative to this corner are on the following page.

I hereby certify that this document was prepared by me or under my direct supervision and that I am a duly Licensed Land Surveyor under the laws of the State of Minnesota.

Daniel D. Baar 12-30-14
Daniel D. Baar Date
Minnesota License No. 45816

- County Surveyor Land Surveyor
 Deputy County Surveyor

OFFICE OF COUNTY SURVEYOR
County of Ramsey

I hereby certify that this document was filed in the County Surveyor's office this 30th day of December, 20 14.

Craig W. Hinzman
Craig W. Hinzman, L.S.
Ramsey County Surveyor

MONUMENT 357N

Witness Monument South of East Quarter Corner of Section 2, Township 29 North, Range 23 West

Corner in lake, set post for Witness Corner to 1/4 Section post (3 chains & 50 links North of position), Bur Oak 8 N48°W 92, November 3, 1847.

The 1/4 Corner on East of Section 2 was fixed by Armstrong December, 1896. Armstrong measured ch. distance North from the 1/4 Corner on East of Section 11 to lake and prorated. Set monument, November 10, 1897.

Ramsey County Re-survey book shows a granite monument set 70.89 ft. South of East Quarter Corner, +/-1897.

Used old ties for digging; dug down 7 ft. and found a granite monument. Placed a cast iron monument over granite monument, down 0.2 ft., April, 1974.

Tied monument, July 31, 1974.

Checked monument, March 26, 1985.

Sign and post set +/-1 ft. Northwesterly of monument, September 19, 1996.

Retied monument, August 9, 2002.

Retied monument, August 6, 2007.

Checked condition of cast iron monument and ties, June 12, 2012.