

MONUMENT 41

CERTIFICATE OF LOCATION OF GOVERNMENT CORNER

Center of Section 5, Township 30 North, Range 22 West, County of Ramsey,
State of Minnesota.


At the corner location shown on the sketch

On February 17, 2005 found 1/2 in. iron in concrete and pipe.

left monument as found lowered monument removed monument (explain)

On _____ placed a _____

SKETCH OF REFERENCE TIES

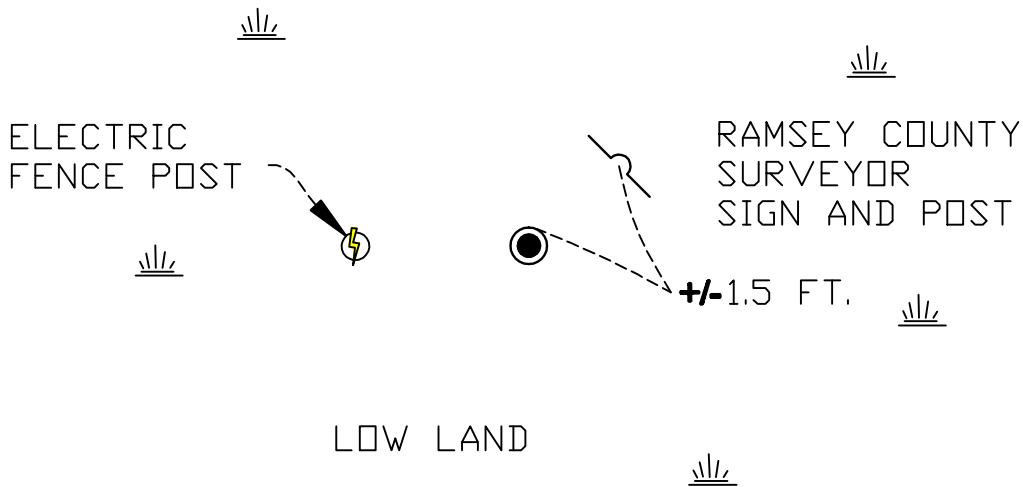

RAMSEY COUNTY
NAD83 (1986) DATUM

MONUMENT 41

X= 579167.831 (Easting)
Y= 218374.747 (Northing)

Statements of evidence relative to this corner are on the following page(s).

I hereby certify that this document and the data contained herein was prepared by me or under my direct supervision this _____ day of _____, 20____.

SIGNATURE

Minnesota License No. _____

County Surveyor Land Surveyor

OFFICE OF COUNTY SURVEYOR

County of Ramsey

I hereby certify that this document was filed in the County Surveyor's office on the ____ day of _____, 20____.

David D. Claypool, P.L.S., County Surveyor

By _____, Deputy

MONUMENT 41

Found ½ in. iron in concrete and pipe. Monument level to swamp and vertical. Placed sign and post +/- 18 in. southeasterly of monument. Iron monument was placed by Milner W. Carley and Assoc., April 25, 1991.

Checked monument and sign. Sign found to be northeasterly of iron pipe, February 17, 2005.