

MONUMENT 445

CERTIFICATE OF LOCATION OF GOVERNMENT CORNER

Northeast Corner of Section 21, Township 29 North, Range 23 West, County of Ramsey, State of Minnesota.


At the corner location shown on the sketch

On August 1, 2012 found a cast iron monument, flush in concrete road.

left monument as found raised/lowered monument removed monument (explain)

On _____ placed a _____

SKETCH OF REFERENCE TIES

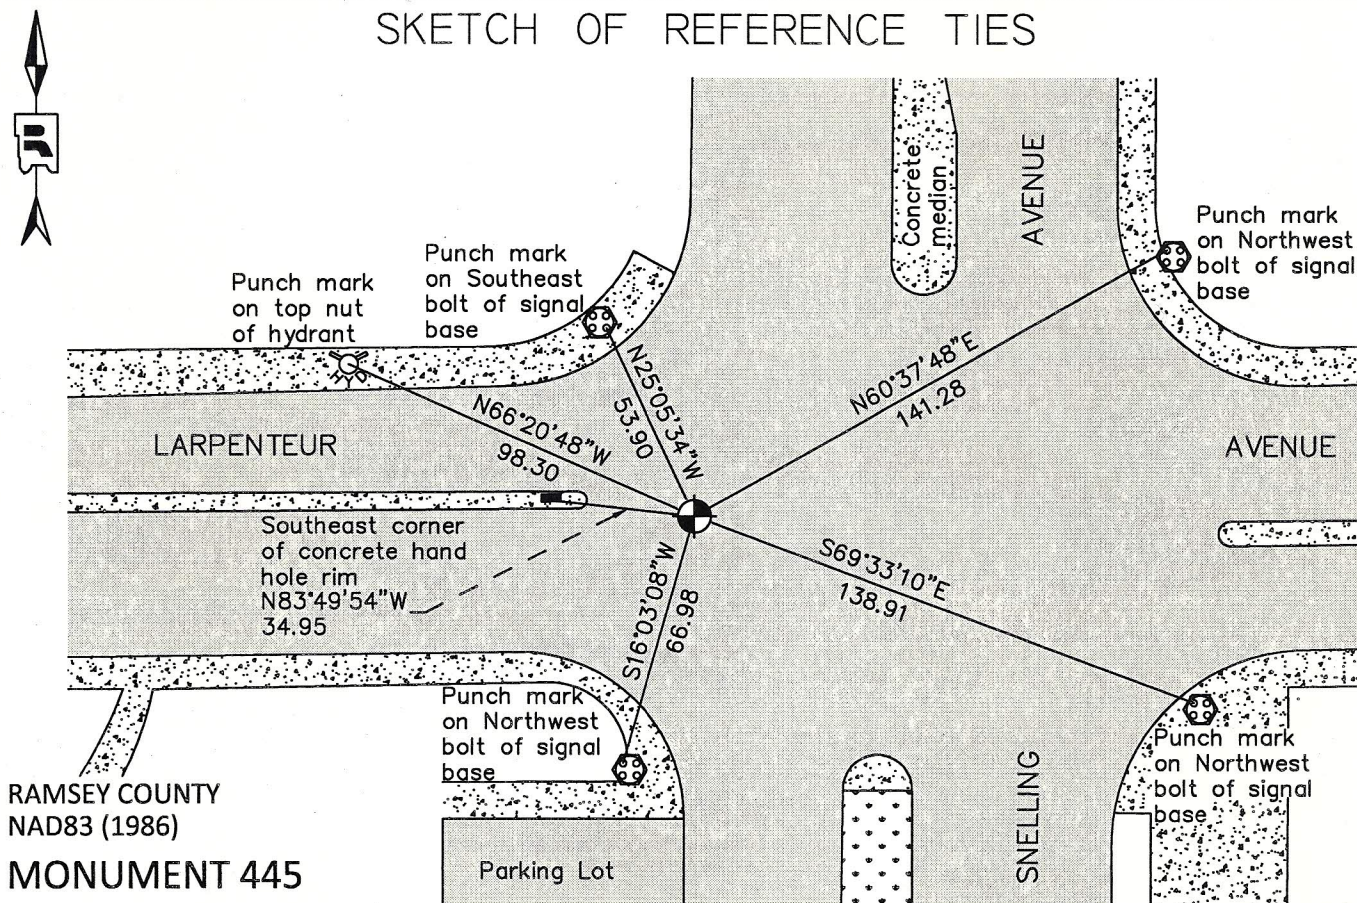

RAMSEY COUNTY
NAD83 (1986)

MONUMENT 445

X= 556012.641 (Easting)
Y= 173235.702 (Northing)

ALL DISTANCES ARE SHOWN IN U.S. SURVEY FEET.
BEARINGS ARE FOR TIE REFERENCE PURPOSES ONLY.

Statements of evidence relative to this corner are on the following page.

I hereby certify that this document was prepared by me or under my direct supervision and that I am a duly Licensed Land Surveyor under the laws of the State of Minnesota.

Daniel D. Baar 2-20-13
Daniel D. Baar Date
Minnesota License No. 45816

- County Surveyor
 Deputy County Surveyor Land Surveyor

OFFICE OF COUNTY SURVEYOR
County of Ramsey

I hereby certify that this document was filed in the County Surveyor's office this 20th day of February, 20 13.

Craig W. Hinzman
Craig W. Hinzman, L.S.
Ramsey County Surveyor

MONUMENT 445

Northeast Corner of Section 21, Township 29 North, Range 23 West

Set post Corner to Sections 15, 16, 21, & 22, Bur Oak 16 N25°E 1.26, "Do" (Bur Oak) 12 S17°W 2.00, November 3, 1847.

Monument set by J. H. Armstrong, March, 1891. (City of Saint Paul Surveyor)

Tied granite monument, at grade, February, 1934. (City of Saint Paul Surveyor)

Tied monument, November, 1957.

Found a P.K. nail, June 18, 1976.

Found a granite monument down 0.35 ft. and set a cast iron cap monument, June 21, 1977.

Checked monument, August 12, 1977.

Cast iron monument set to grade, September, 1978. (City of Saint Paul Surveyor)

Monument removed by State construction, 1986.

Relocated position and drilled hole and four tie holes, 1987.

Found drill hole with four drill hole straddles and tied, April 16, 1991. (City of Saint Paul Surveyor)

Set a cast iron cap and bolt monument, July, 1994.

Tied monument, August 2, 1994.

Retied monument, March 28, 2001.

Retied monument, September 5, 2007.

Tied cast iron monument, November 30, 2009. (City of Saint Paul Surveyor)

Checked condition of monument and ties; found cast iron monument, flush in concrete road with worn top, August 1, 2012.