

MONUMENT 45

CERTIFICATE OF LOCATION OF GOVERNMENT CORNER

Center of Section 3, Township 30 North, Range 22 West, County of Ramsey,
State of Minnesota.


At the corner location shown on the sketch

On January 26, 2005 found a 1.5 inch iron pipe down 0.1 ft.

left monument as found lowered monument removed monument (explain)

On February 11, 2005 placed a 3/4 in. aluminum rod with cast iron cap monument
in concrete, 4 in. above water level.

SKETCH OF REFERENCE TIES

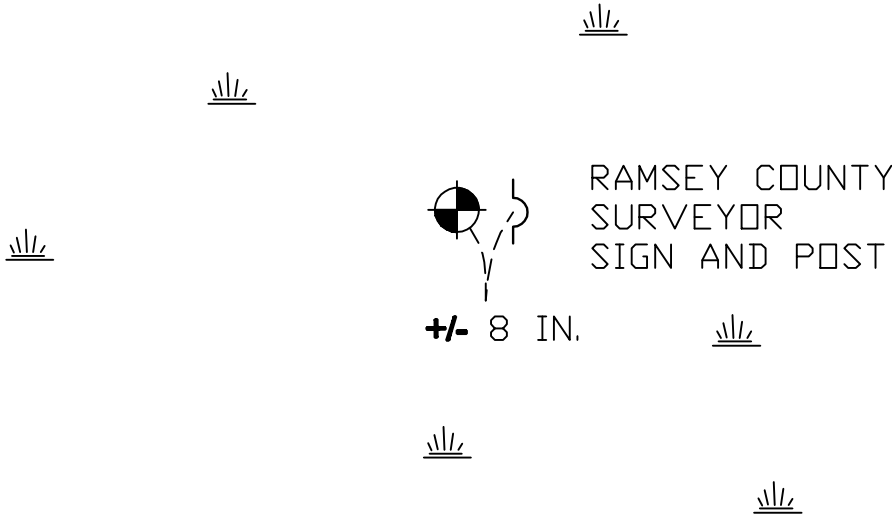

RAMSEY COUNTY
NAD83 (1986) DATUM

MONUMENT 45

X= 589722.203 (Easting)
Y= 218453.440 (Northing)

Statements of evidence relative to this corner are on the following page(s).

I hereby certify that this document and the data contained herein was prepared by me or under my direct supervision this _____ day of _____, 20____.

SIGNATURE

Minnesota License No. _____

County Surveyor Land Surveyor

OFFICE OF COUNTY SURVEYOR

County of Ramsey

I hereby certify that this document was filed in the County Surveyor's office on the ____ day of _____, 20____.

David D. Claypool, P.L.S., County Surveyor

By _____, Deputy

MONUMENT 45

Found 1.5 in. inside diameter iron pipe up +/- 2.5 ft. in swamp. Placed sign and post +/- 8 in. easterly, April 26, 1991.

Found 1.5 in. iron pipe broken off; dug down 0.1 ft. and found remainder of pipe in place, January 26, 2005.

Found 2 in. pipe rusted off at water line. Found base and chipped down 12 in. and found base of pipe in good condition. Placed $\frac{3}{4}$ in. aluminum rod in center of pipe, pounded 20 ft. of rod down to good resistance and set cast iron cap monument up 4 in. above water level. Filled pipe around rod with concrete and filled hole with sand and concrete mix. No ties taken, nothing but cattails, February 11, 2005.