

MONUMENT 456E WC

CERTIFICATE OF LOCATION OF GOVERNMENT CORNER

Witness Monument to the Meander Corner on the South Line of the Southeast Quarter of Section 16, Township 29 North, Range 22 West, County of Ramsey, State of Minnesota.


At the corner location shown on the sketch

On July 27, 2006 found a cast iron monument.

left monument as found lowered monument removed monument (explain)

On _____ placed a _____

SKETCH OF REFERENCE TIES

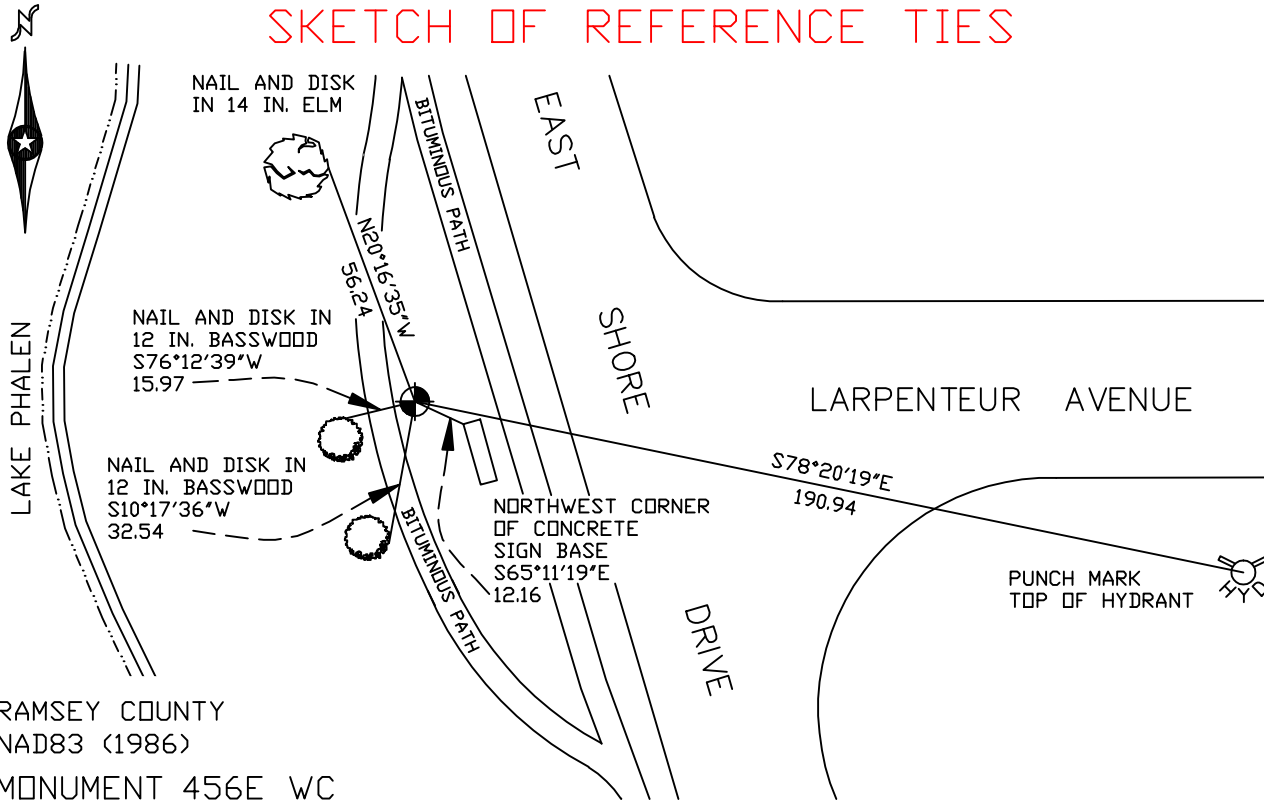

RAMSEY COUNTY
NAD83 (1986)
MONUMENT 456E WC

X= 585674.462 (Easting)
Y= 173426.879 (Northing)

ALL DISTANCES ARE SHOWN IN U.S. SURVEY FEET.
BEARINGS ARE FOR TIE REFERENCE PURPOSES ONLY.

Statements of evidence relative to this corner are on the following page(s).

I hereby certify that this document and the data contained herein was prepared by me or under my direct supervision this _____ day of _____, 20____.

SIGNATURE

Minnesota License No. _____

County Surveyor Land Surveyor

OFFICE OF COUNTY SURVEYOR

County of Ramsey

I hereby certify that this document was filed in the County Surveyor's office on the ____ day of _____, 20____.

David D. Claypool, P.L.S., County Surveyor

By _____, Deputy

MONUMENT 456E WC

Monument destroyed by storm sewer placement, no date given in field book. Never replaced. Determined mathematical location and placed position 74 ft. east of M.C. on line to the east, August 23, 1989.

Placed 20 in. cast iron monument, May 11, 1990.

Retied monument, October 12, 2001.

Retied monument, July 27, 2006.