

MONUMENT 532

CERTIFICATE OF LOCATION OF GOVERNMENT CORNER

East Quarter Corner of Section 25, Township 29 North, Range 22 West, County of Ramsey, State of Minnesota.


At the corner location shown on the sketch

On June 7, 2011 found a granite monument, within a cast iron manhole assembly.

left monument as found raised/lowered monument removed monument (explain)

On _____ placed a _____

SKETCH OF REFERENCE TIES

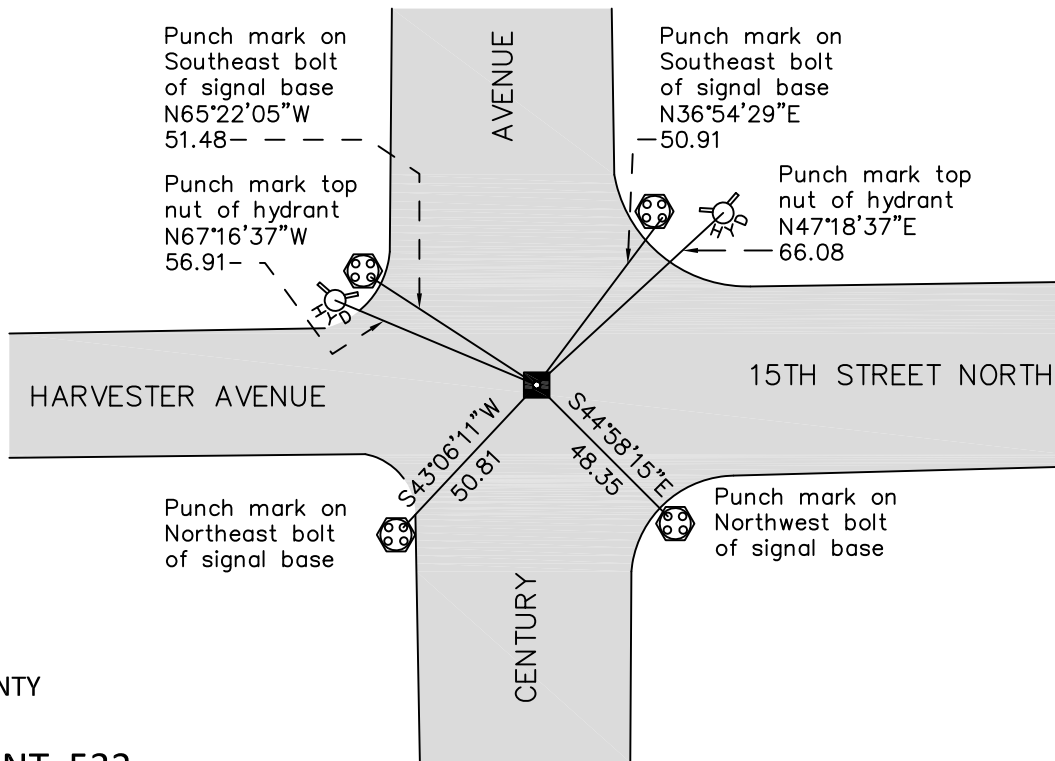

RAMSEY COUNTY
NAD83 (1986)

MONUMENT 532

X= 603134.869 (Easting)
Y= 165656.780 (Northing)

ALL DISTANCES ARE SHOWN IN U.S. SURVEY FEET.
BEARINGS ARE FOR TIE REFERENCE PURPOSES ONLY.

Statements of evidence relative to this corner are on the following page.

I hereby certify that this document was prepared by me or under my direct supervision and that I am a duly Licensed Land Surveyor under the laws of the State of Minnesota.

Daniel D. Baar Date
Minnesota License No. 45816

County Surveyor
 Deputy County Surveyor Land Surveyor

OFFICE OF COUNTY SURVEYOR
County of Ramsey

I hereby certify that this document was filed in the County Surveyor's office this _____ day of _____, 20 ____.

Craig W. Hinzman, L.S.
Ramsey County Surveyor

MONUMENT 532

East Quarter Corner of Section 25, Township 29 North, Range 22 West

Set post at Quarter Section Corner, White Oak 6 S1°E 55, White Oak 10 N1°W 120, October 15, 1847.

In establishing the 1/4 Corner on the East line of Section 25 (on County Line) found old stake which checked the center of road running east in Washington County, no Government witness trees, set monument August 11, 1897.

Found iron over granite monument. Granite monument down +/-1 ft., placed 10 in. cast iron monument, July 30, 1975.

Tied monument, February 20, 1976.

Retied monument, down 0.15 ft., September 24, 1993.

Removed 10 in. cast iron monument for road milling project. Placed cast iron manhole assembly over granite monument, June, 2005.

Tied monument, July 20, 2006.

Retied granite monument, within a cast iron manhole assembly, June 7, 2011.