

MONUMENT 715


CERTIFICATE OF LOCATION OF SECTION SUBDIVISION MONUMENT

Center of Section 13, Township 28 North, Range 22 West, County of Ramsey, State of Minnesota.

At the corner location shown on the sketch

- On May 22, 2012 found a cast iron monument in bituminous road.
- left monument as found
 raised/lowered monument
 removed monument (explain)
- On May 22, 2012 placed a new 20 in. cast iron monument within a cast iron manhole assembly,
+/-8 in. below finished grade, using construction ties.

SKETCH OF REFERENCE TIES

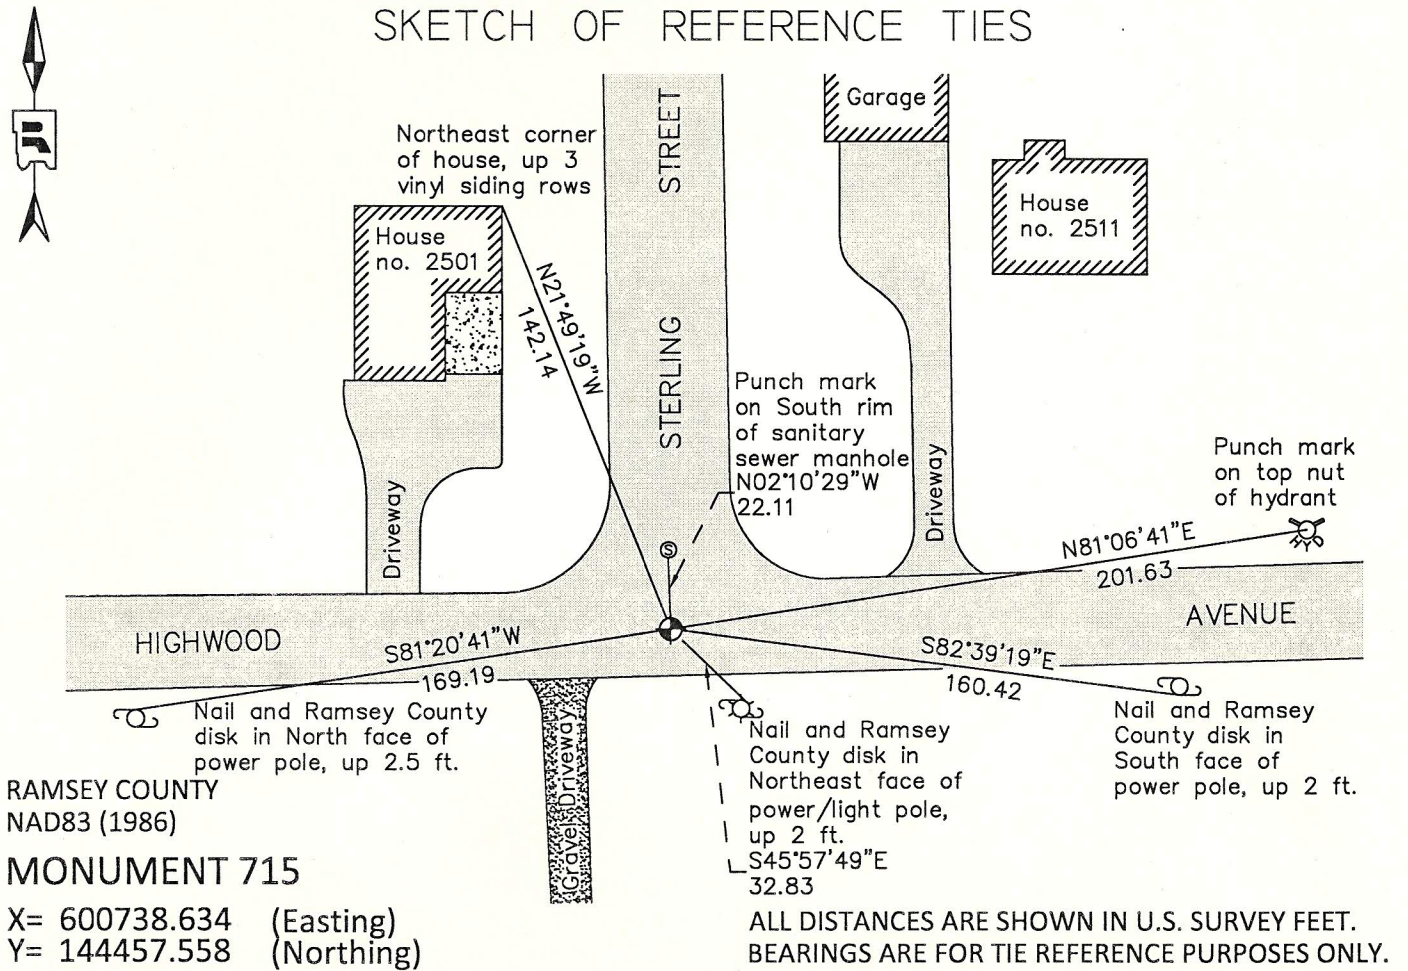

Statements of evidence relative to this corner are on the following page.

I hereby certify that this document was prepared by me or under my direct supervision and that I am a duly Licensed Land Surveyor under the laws of the State of Minnesota.

Daniel D. Baar 2-20-13
 Daniel D. Baar Date
 Minnesota License No. 45816

County Surveyor
 Deputy County Surveyor Land Surveyor

OFFICE OF COUNTY SURVEYOR
 County of Ramsey

I hereby certify that this document was filed in the County Surveyor's office this 20th day of February, 20 13.

Craig W. Hinzman
 Craig W. Hinzman, L.S.
 Ramsey County Surveyor

MONUMENT 715

Center of Section 13, Township 28 North, Range 22 West

Fixed the Center of Section 13 by intersection, April 4, 1899.

Set monument, April 9, 1899.

Re-established Center of Section, October 31, 1934.

Tied iron monument, March, 1967.

Found 1/2 in. inner diameter pipe down +/-4 in. and 2 P.K. nails at same depth in old blacktop, August 5, 1974.

HIGHWOOD ESTATES plat shows an iron pipe at described location, May 2, 1988.

Set a 20 in. cast iron monument, August 4, 1997.

Tied monument, July 15, 1998.

Retied monument, August 21, 2006.

Retied cast iron monument flush in bituminous roadway, June 1, 2011.

Tied monument for removal during road reconstruction, May 2, 2012.

Removed 20 in. cast iron monument; dug down 28 in. below road grade, found nothing. Set a new "Ramsey County" 20 in. cast iron monument within a cast iron manhole assembly using construction ties. Tied monument, May 22, 2012.

2012