

# MONUMENT 739N

## CERTIFICATE OF LOCATION OF GOVERNMENT CORNER

Meander Corner no. 18 on East Line of Section 13, Township 28 North, Range 22 West, County of Ramsey, State of Minnesota.


At the corner location shown on the sketch

On October 11, 2012 found a "Ramsey County" cast iron monument down 0.2 ft., in flower garden.

left monument as found       raised/lowered monument       removed monument (explain)

On \_\_\_\_\_ placed a \_\_\_\_\_

### SKETCH OF REFERENCE TIES

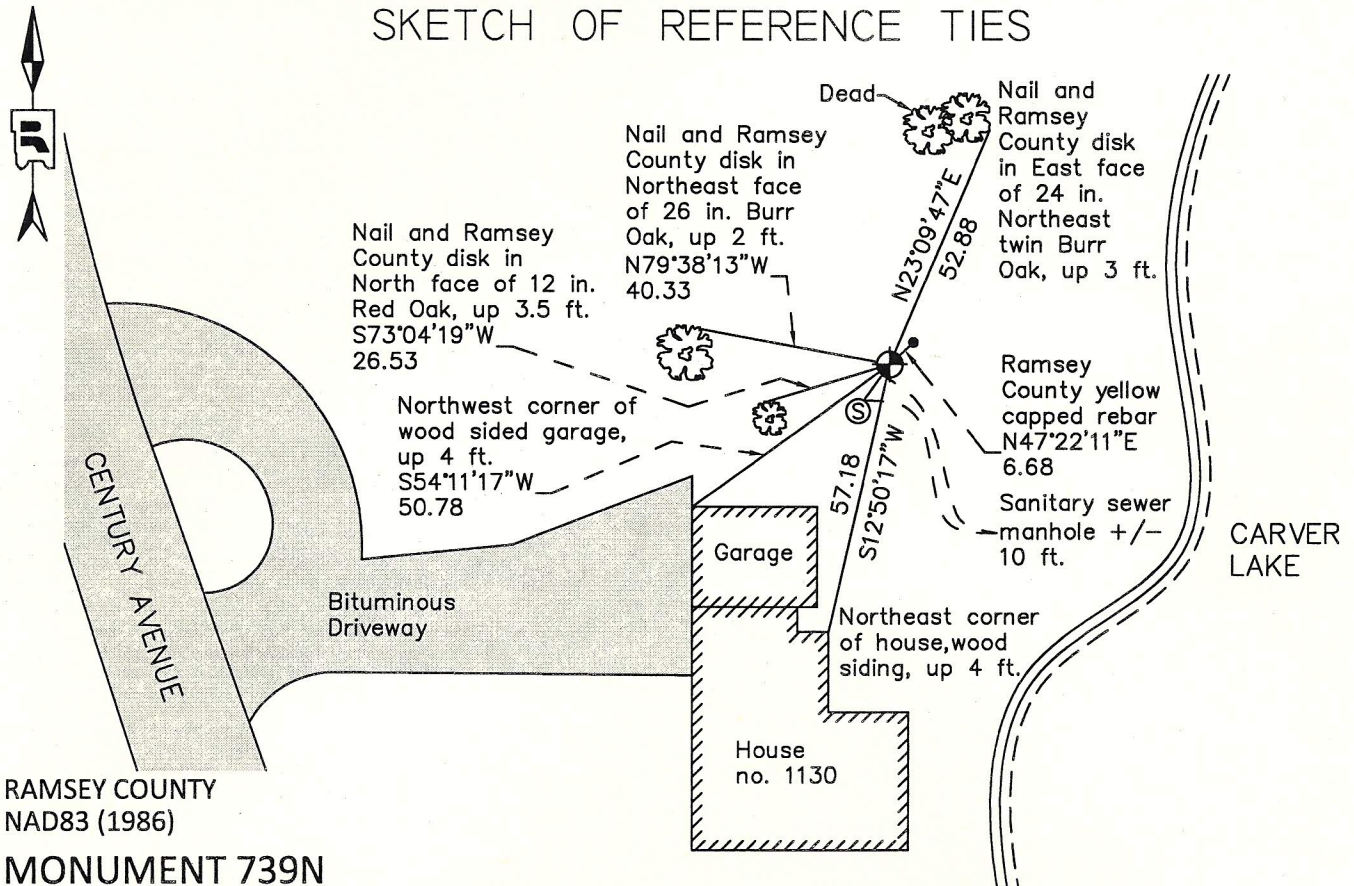

X= 603381.936 (Easting)  
Y= 142731.738 (Northing)

ALL DISTANCES ARE SHOWN IN U.S. SURVEY FEET.  
BEARINGS ARE FOR TIE REFERENCE PURPOSES ONLY.

Statements of evidence relative to this corner are on the following page.

I hereby certify that this document was prepared by me or under my direct supervision and that I am a duly Licensed Land Surveyor under the laws of the State of Minnesota.

Daniel D. Baar      2-20-13  
Date

Daniel D. Baar  
Minnesota License No. 45816

County Surveyor  
 Deputy County Surveyor       Land Surveyor

OFFICE OF COUNTY SURVEYOR  
County of Ramsey

I hereby certify that this document was filed in the County Surveyor's office this 20th day of February, 20 13.

Craig W. Hinzman  
Craig W. Hinzman, L.S.  
Ramsey County Surveyor

# MONUMENT 739N

Meander Corner no. 18 on East Line of Section 13, Township 28 North, Range 22 West

Set Meander post, B. Oak 8 N25°W 28, September 30, 1847.

Meander Corner No. 43 was fixed, August 27, 1897. (Ramsey County Re-Survey calls this Meander Corner No. 43; this is Meander Corner No. 18 on the GLO plat)

Monument set, September 2, 1897.

Found a granite monument down 0.3 ft. and tied, August 6, 1974.

Monument destroyed by sewer construction; placed a witness corner, October 27, 1977.

Set a cast iron monument; no date given in field book.

Tied monument, October 8, 1984.

Replaced monument after sewer service construction; tied, May 2, 1989.

Retied monument, down 4 in. in flower bed, April 18, 2001.

Retied monument, July 17, 2007.

Found "Ramsey County" cast iron monument, down 0.2 ft. in flower bed; retied, October 11, 2012.