

MONUMENT 77

CERTIFICATE OF LOCATION OF FOUND MONUMENT

Center of Section 7, Township 30 North, Range 23 West, County of Ramsey, State of Minnesota.


At the corner location shown on the sketch

On September 7, 2011 found a cast iron monument within a cast iron manhole assembly.

left monument as found raised/lowered monument removed monument (explain)

On _____ placed a _____

SKETCH OF REFERENCE TIES

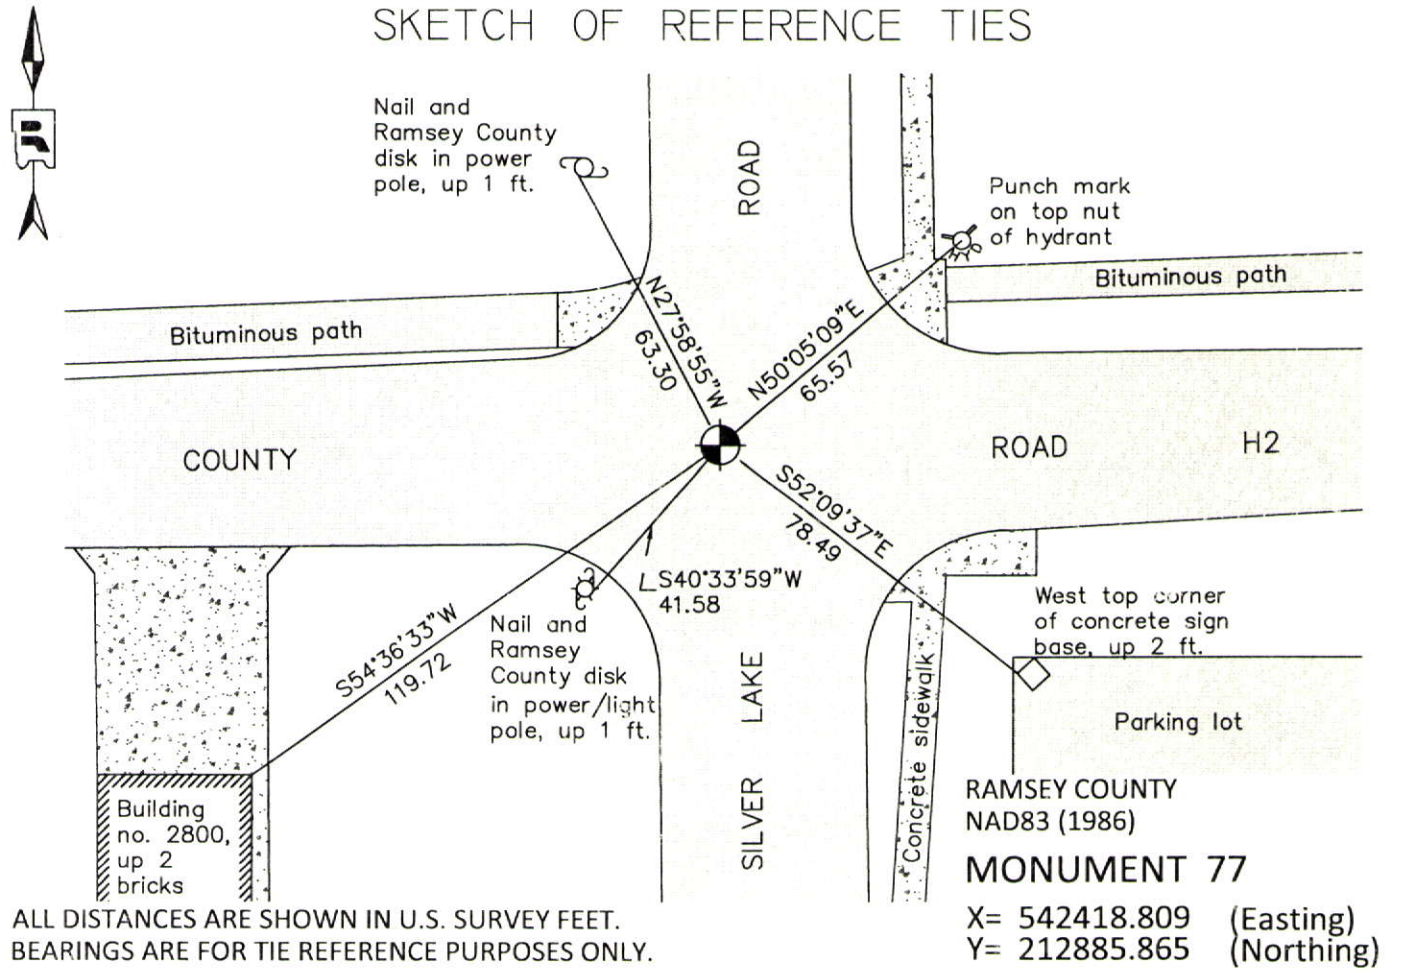

Statements of evidence relative to this corner are on the following page.

I hereby certify that this document was prepared by me or under my direct supervision and that I am a duly Licensed Land Surveyor under the laws of the State of Minnesota.

Daniel D. Baar 12-30-14
 Daniel D. Baar Date
 Minnesota License No. 45816

County Surveyor Land Surveyor
 Deputy County Surveyor

OFFICE OF COUNTY SURVEYOR
 County of Ramsey

I hereby certify that this document was filed in the County Surveyor's office this 30th day of December, 20 14.

Craig W. Hinzman
 Craig W. Hinzman, L.S.
 Ramsey County Surveyor

MONUMENT 77

Center of Section 7, Township 30 North, Range 23 West

Fixed the Center of Section 7 by Intersection, June 24, 1903 and set Monument.

The plat of SPRING LAKE PARK KNOLLS ADDITION, RAMSEY COUNTY, MINNESOTA, shows a granite monument at the Center of Section, January 24, 1940.

Tied cast iron monument, February, 1967 (The origin of the cast iron monument is unknown).

Found cast iron monument down 0.1 ft. and retied, August 19, 1975.

Retied monument, September 17, 1993.

Retied monument, down 0.25 ft., March 19, 2001.

Retied monument for City of Mounds View road reconstruction of Co. Rd. H2, August 12, 2002.

Relocated position; set 20 in. cast iron monument within a cast iron manhole assembly, May 20, 2003.

Tied monument, August 28, 2006.

Retied cast iron monument within a cast iron manhole assembly, September 7, 2011.