


36

Hudson Road

North Afton Road

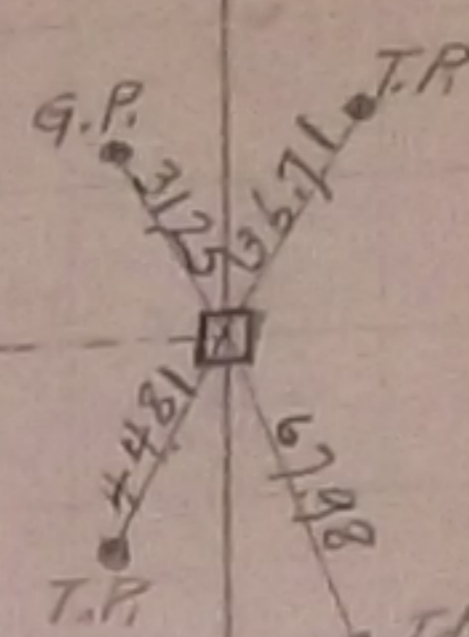

22.07 18° 18' N 4' 0"

47.5 8° 11' 0" 4' 0"

28.51

South Afton Road

EP #123

12

57.11 15° 13' 0"

51.65 8° 13' E

13

57.85 EP #136

52.72 4° F

24