

55.60

2631.50

Tied June 27/22 2631.50

TP  
75.37 20  
75.82 95

84.75  
Oak

1240

71.10  
pole # 599  
F.P.

39.23 T.P. #600  
55.50  
39.35 Pole #600  
8'

90° 35'

2575 pole # 627

2626.65

ST. PAUL & DULUTH R.R.

2642.02

10

90° 18' cal  
Scrub

Tied June 27/22

2651.84 OK

89° 15'  
Tree 77.50

68.23  
T.P.

78.78 03'  
58.72 T.P.  
71.79  
03'

Tree 76.28

2626.65

2634.20 OK

2625.50

FP 1607

11207 T.P. side

7.0  
65.15

Tied June 27/22

WHITE BEAR ROAD

TP 0312  
52.69 T.P.

876

2652.55

5426 T.P.

2665.16  
7065.16

738.88


2 Nails in  
Base of 7x0.5'  
54°15' 71' TP

39.60 Nail in stump of  
7x0.18' 53° E.

PRB  
6/1/25



SEC 10

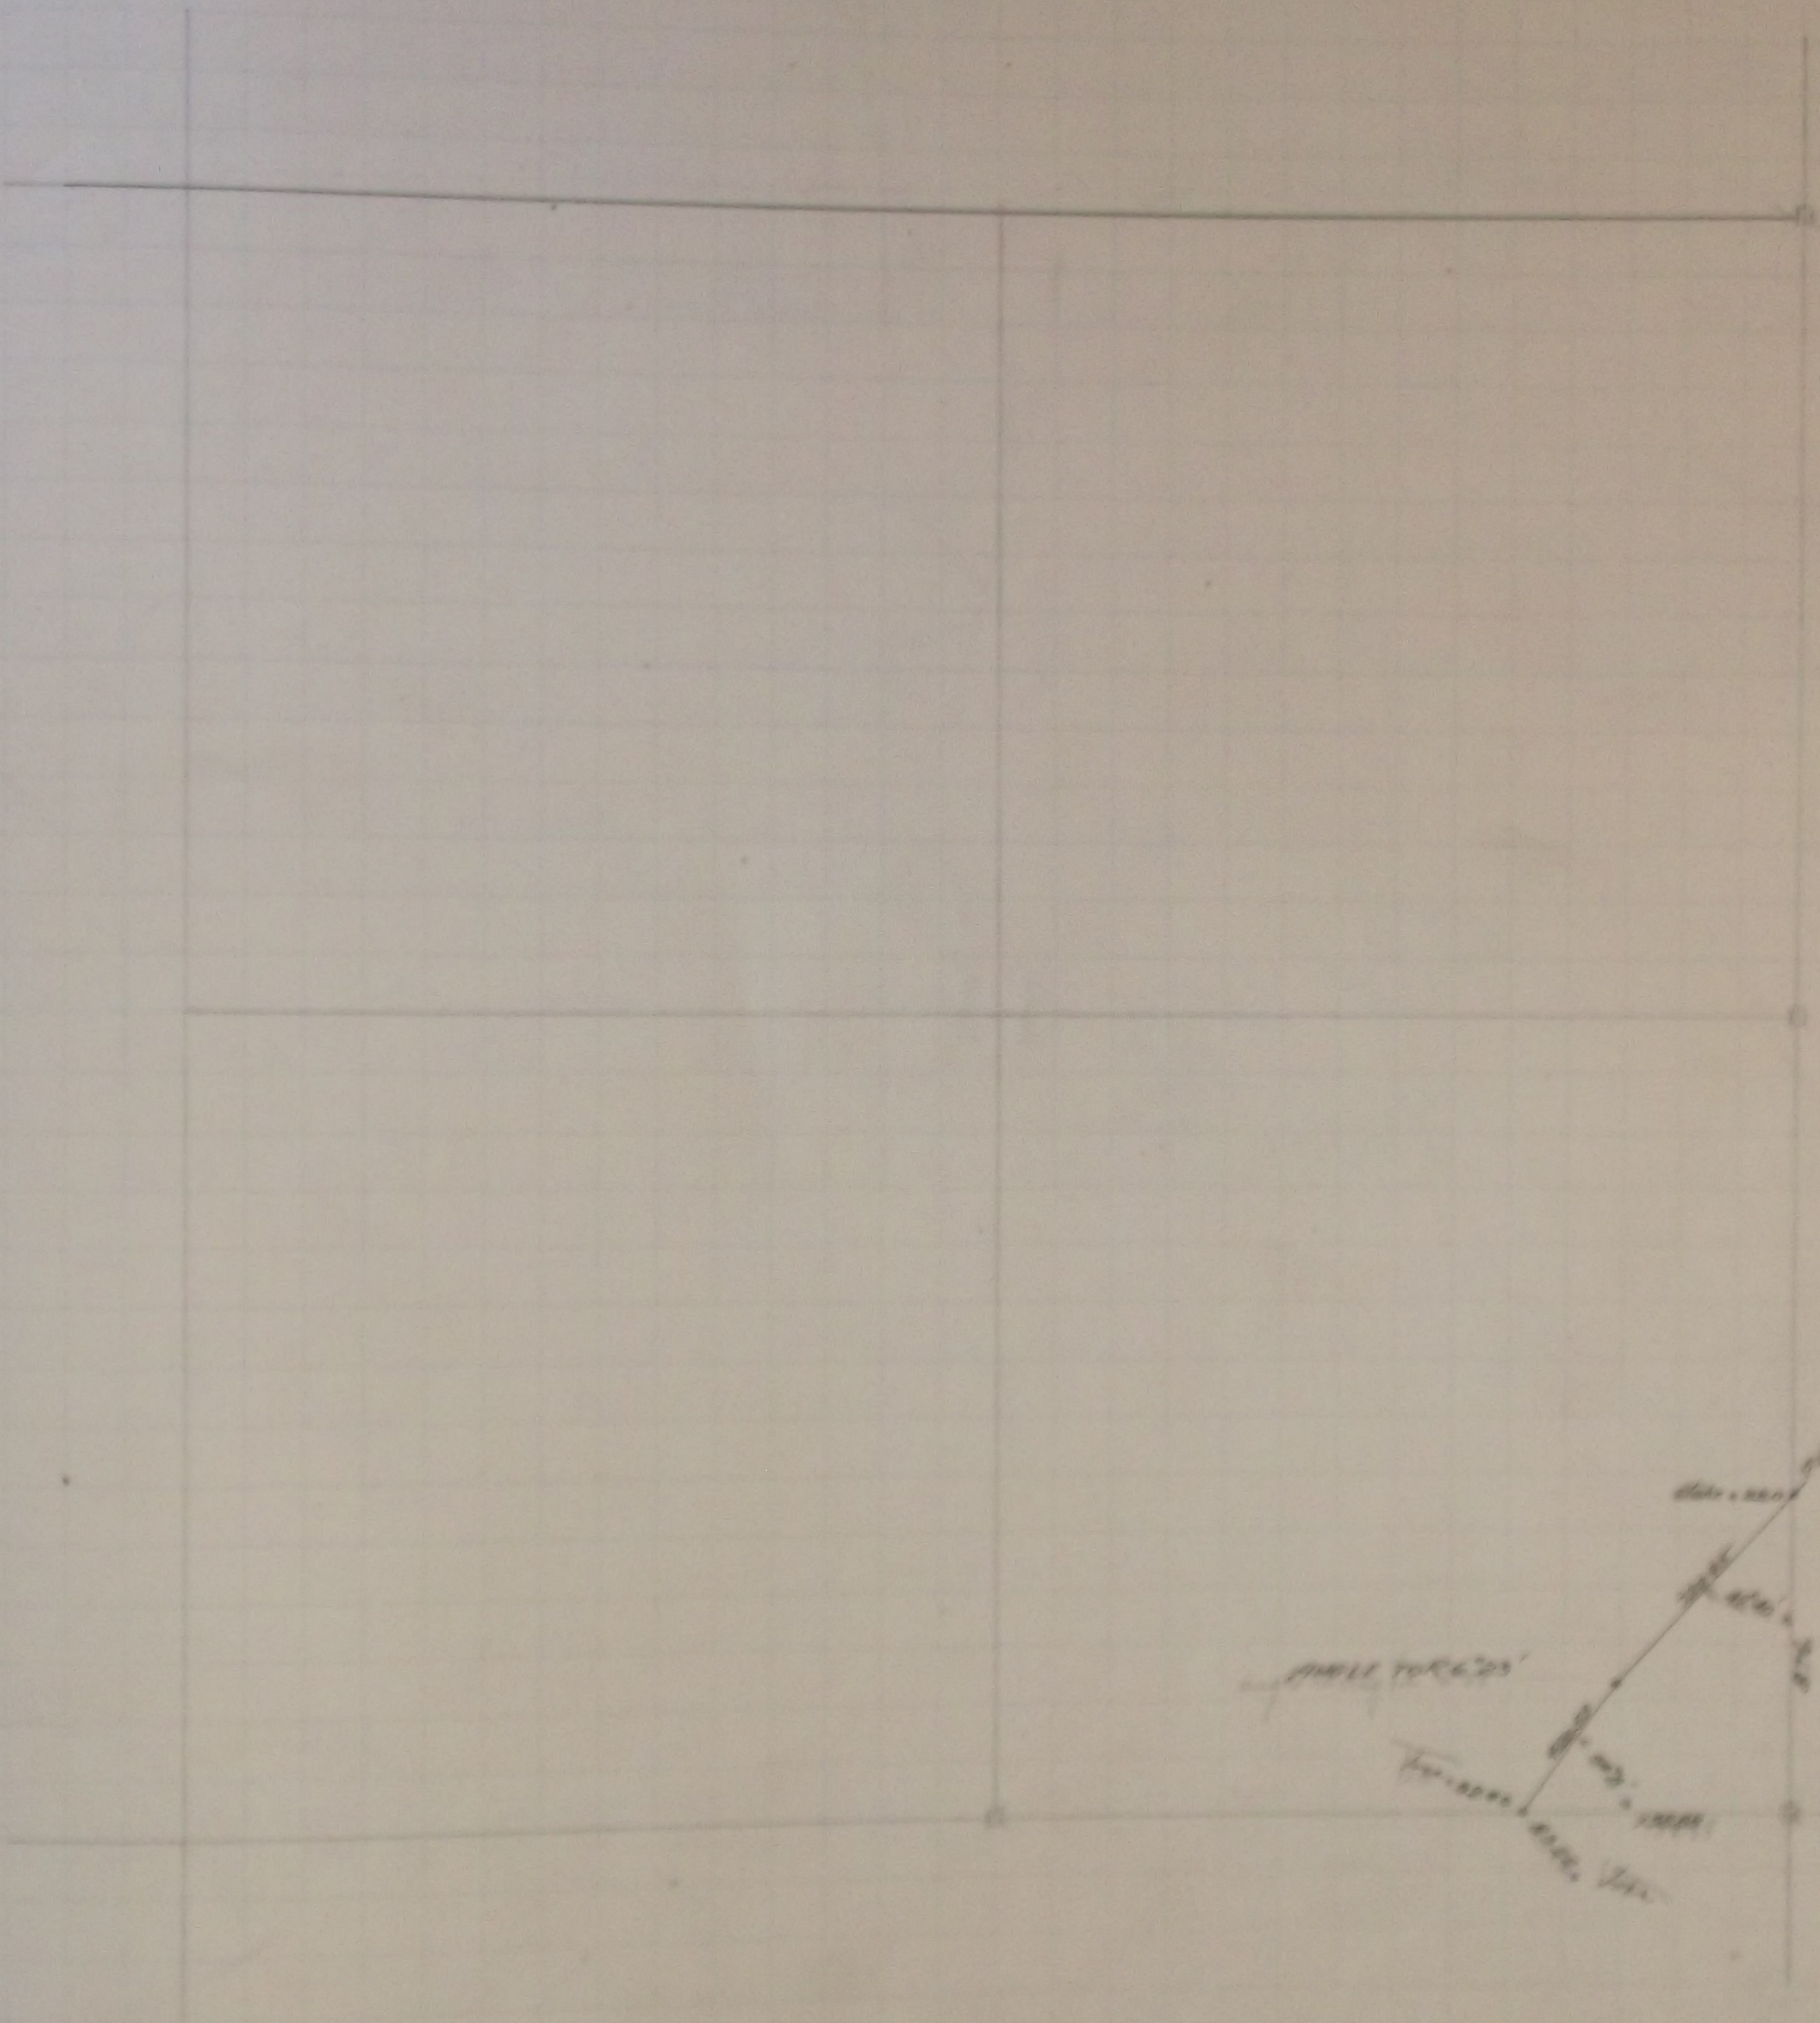



The South East Corner of Section 10 was fixed in June 1896 Set Monument  
Found Government witness stump

The  $\frac{1}{4}$  Corner between Sections 10 and 11 was fixed in June 1896 Set Monument  
Found Iron stake

The  $\frac{1}{4}$  Corner between Sections 10 & 15 was fixed in June 1896 Set Monument

The North East Corner of Section 10 was fixed in July 1896 Set Monument  
Found part of old stake

In Establishing the  $\frac{1}{4}$  corner between Sections 3 and 10 found old stake which checked  
old fences Government trees gone Dec 21-1898 Set Mont. Nov. 1899

In Establishing the S.W. corner of Section 10 found old stake at Section Corner  
4ft underground Government trees gone Set Mont. Nov. 1899

In Establishing the  $\frac{1}{4}$  corner between Sections 9 & 10 Ran straight line from  
corner to corner and fixed  $\frac{1}{4}$  corner  $\frac{1}{2}$  way Government trees gone  
Set monument Nov. 1899

In Establishing the N.W. Corner of Section 10 found old ties Government witness  
trees gone Set monument Aug 18-1898

Fixed the Centre of Section 10 by Intersection and set Monument Oct 19-1900