


OCT 1920

oct-1920

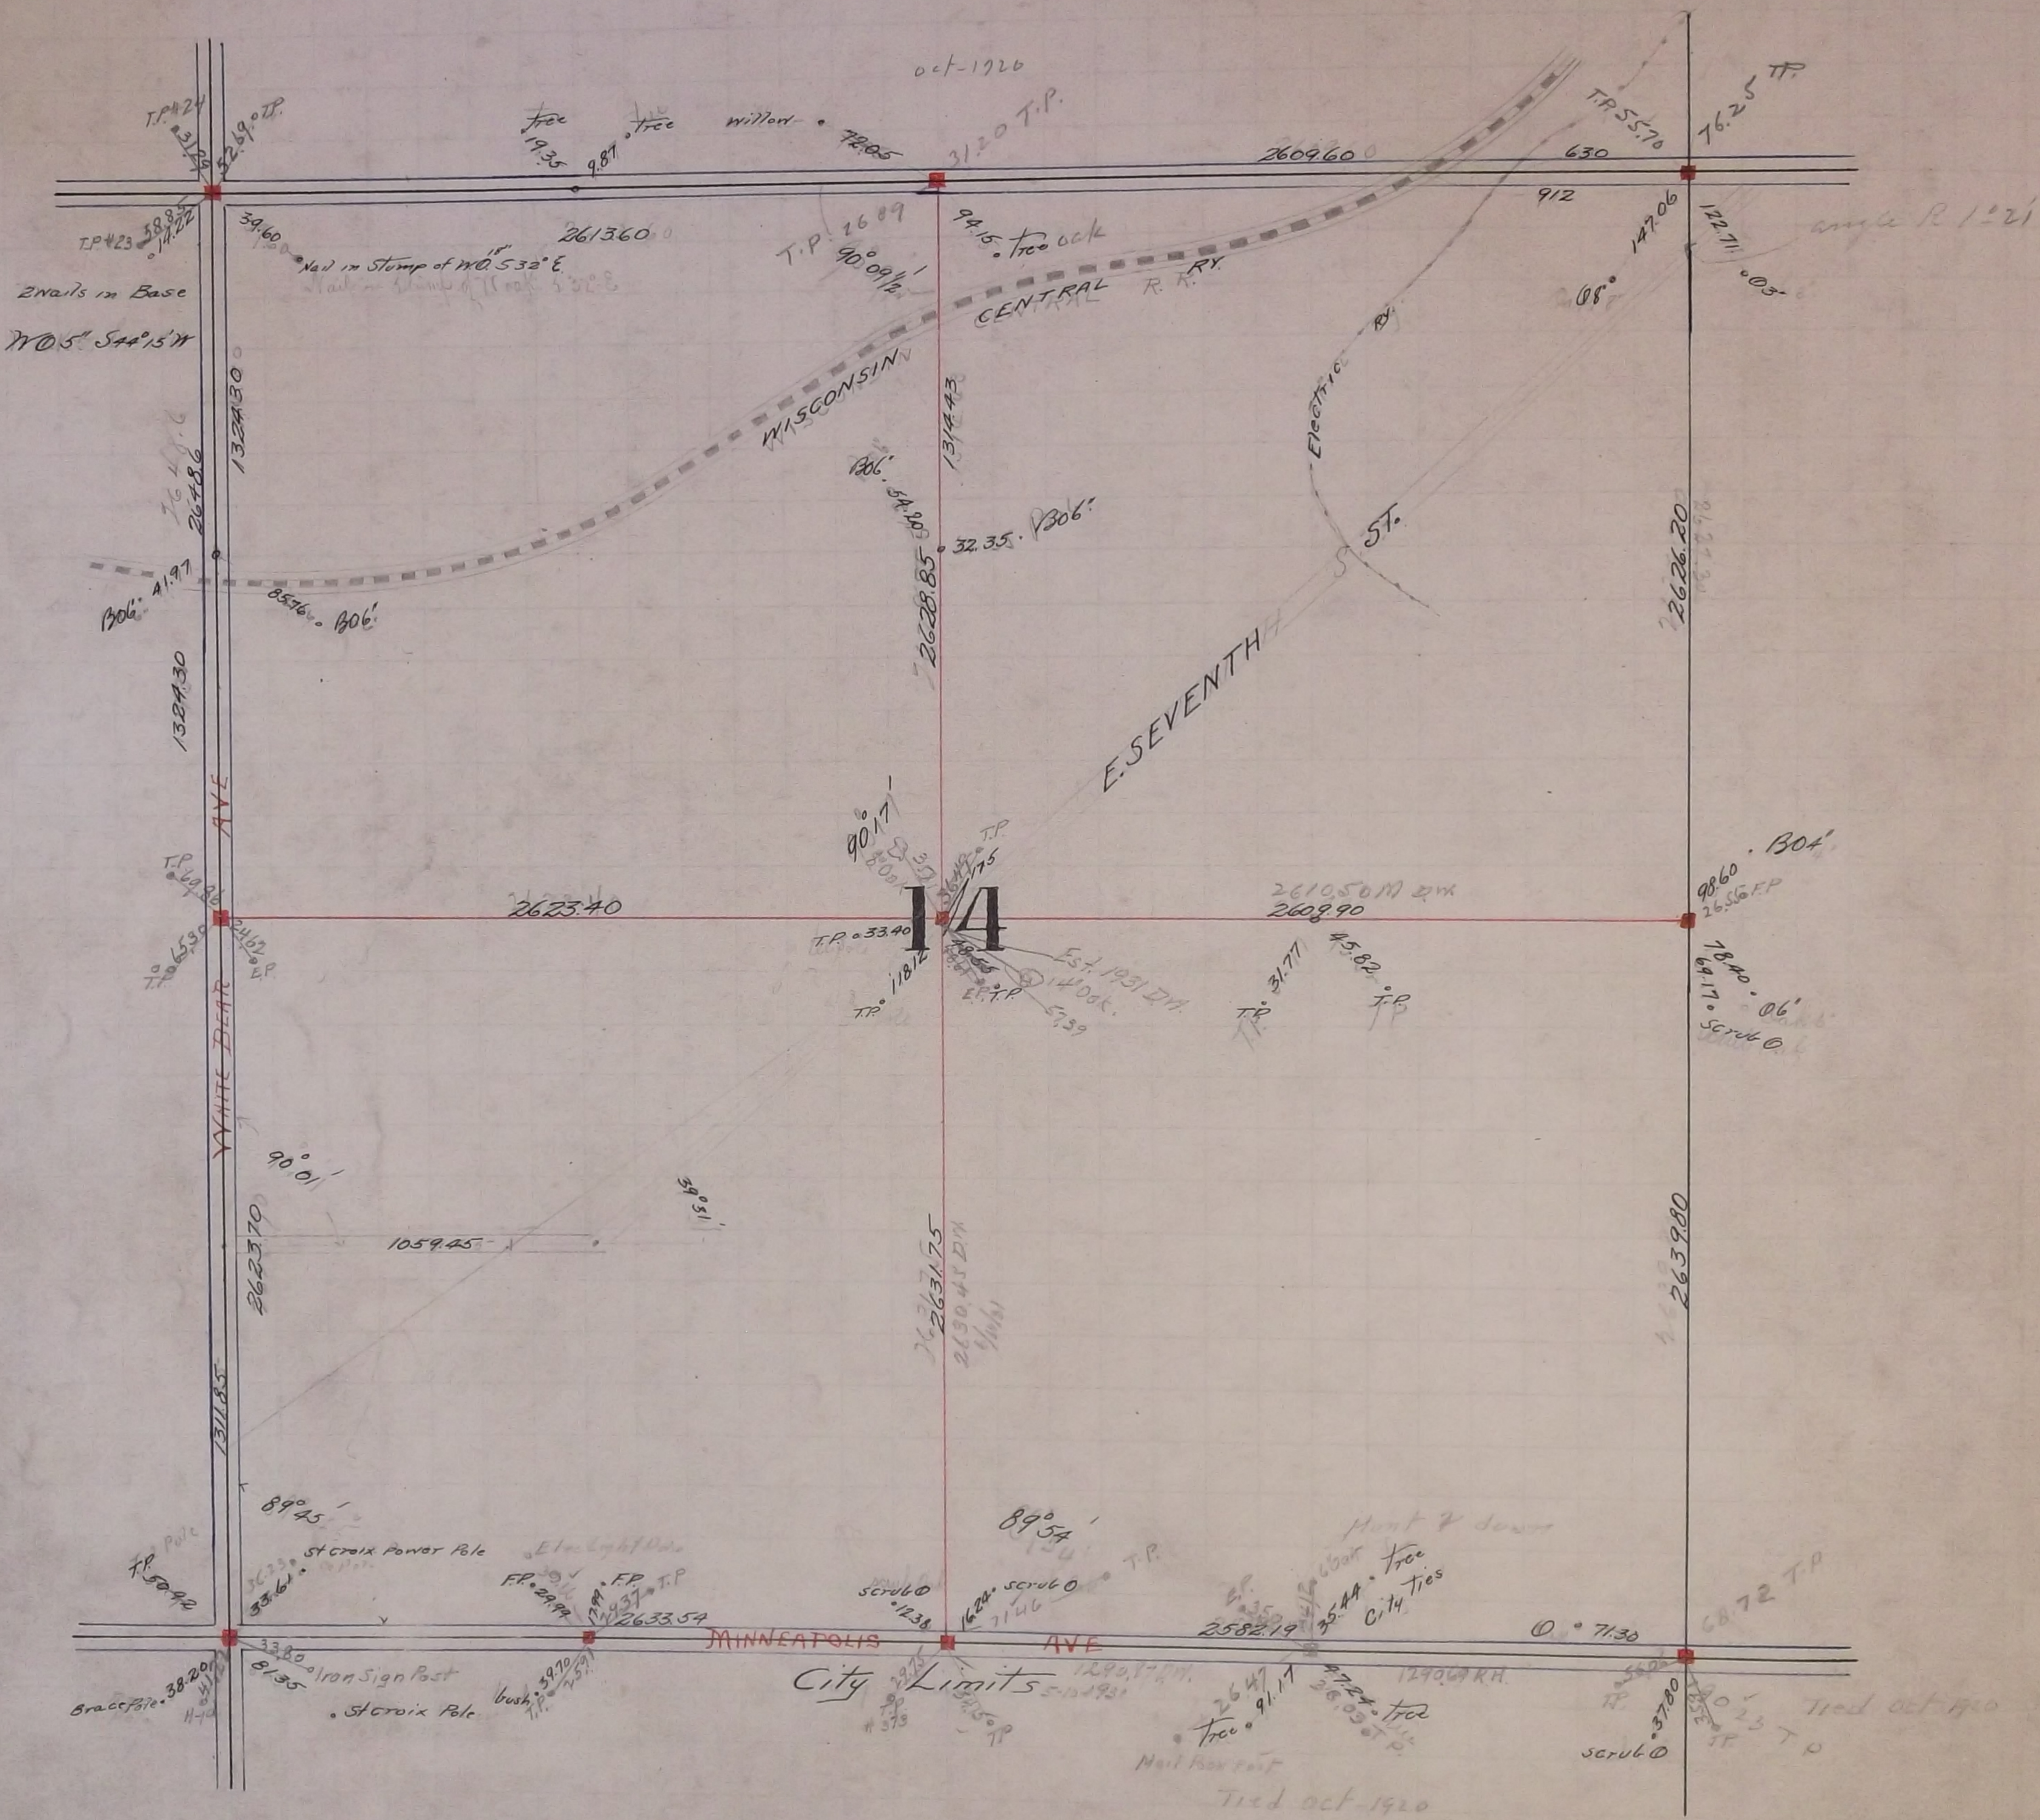

T.P. 24  
23.12

Free 19.35  
tree 9.87  
willow 72.05  
3120 T.P.

T.P. 55.70  
76.25 T.P.

2 nails in Base  
 $N 05^{\circ} 54^{\circ} 15' W$

39.60  
Nail in Stump of No. 532 E  
Nail in Stump of No. 532 E

T.P. 26.89  
 $90^{\circ} 09' 1/2$

94.15 tree oak  
CENTRAL R.R.

912

122.71  
08  
147.06  
angle R 1921

132430

WISCONSIN

Electric R.R.  
ST.

1306' 41.97  
0576' 306'

1306' 54.205  
32.35' 1306'

E. SEVENTH ST.

2626.20

$90^{\circ} 17'$

14

2610.50 M DM  
2609.90

1304'  
9860  
2656 F.P.  
1840' 06'  
scrub 0

2623.40

T.P. 33.40  
T.P. 118.12

Est. 1931 DM  
1400k.  
57.39

T.P. 31.77  
45.82 F.P.

$90^{\circ} 01'$

1059.45

59.31

2626.75  
2630.45 DM  
1/16/11

2639.80

$89^{\circ} 45'$

ST. CROIX POWER POLE

Electric Light Pole

$89^{\circ} 54'$

scrub 0  
1238

1622' scrub 0  
7146

2582.19

Mont & down

tree ties

$0^{\circ} 71.30$

68.72 T.P.

Grace Pole 38.20  
H-10

3380 Iron Sign Post  
81.35

St. Croix Pole

bush 39.70  
75.71

MINNEAPOLIS City Limits

AVE

1290.1 DM  
5-12-1931

2647 tree  
91.17

2605.07 T.P.

tree

Nail Box Post

Tied Oct 1920

scrub 0  
37.80

25.23 Tied Oct 1920  
T.P.



The South West corner of Section 14 Fixed by City Engineer & Monument

The  $\frac{1}{4}$  corner between Sections 11 and 14 found one old Government witness stump  
Fixed corner tied it Aug 22 1896 Set Monument

The North West corner of Section 14 1896 Set monument  
Found Government witness stump

The  $\frac{1}{4}$  corner between Sections 14 and 15 found old stake 1895 Set Monument  
no Government trees

In Establishing the N.E. corner of Section 14 found Iron stake at Section corner  
Government trees gone Set Mont. Nov. 1899

In Establishing the  $\frac{1}{4}$  corner between Sections 14 and 15 found old stake  
Government witness trees gone Set monument 1895

In Establishing the  $\frac{1}{4}$  corner between Sections 13 and 14 found old stake at  $\frac{1}{4}$  corner  
which was fixed when old Government trees were standing  
Fixed corner and set mont. Aug 1900

Fixed the centre of Section 14 by Intersection and set mont.  
Aug 1900.