


SEC 15

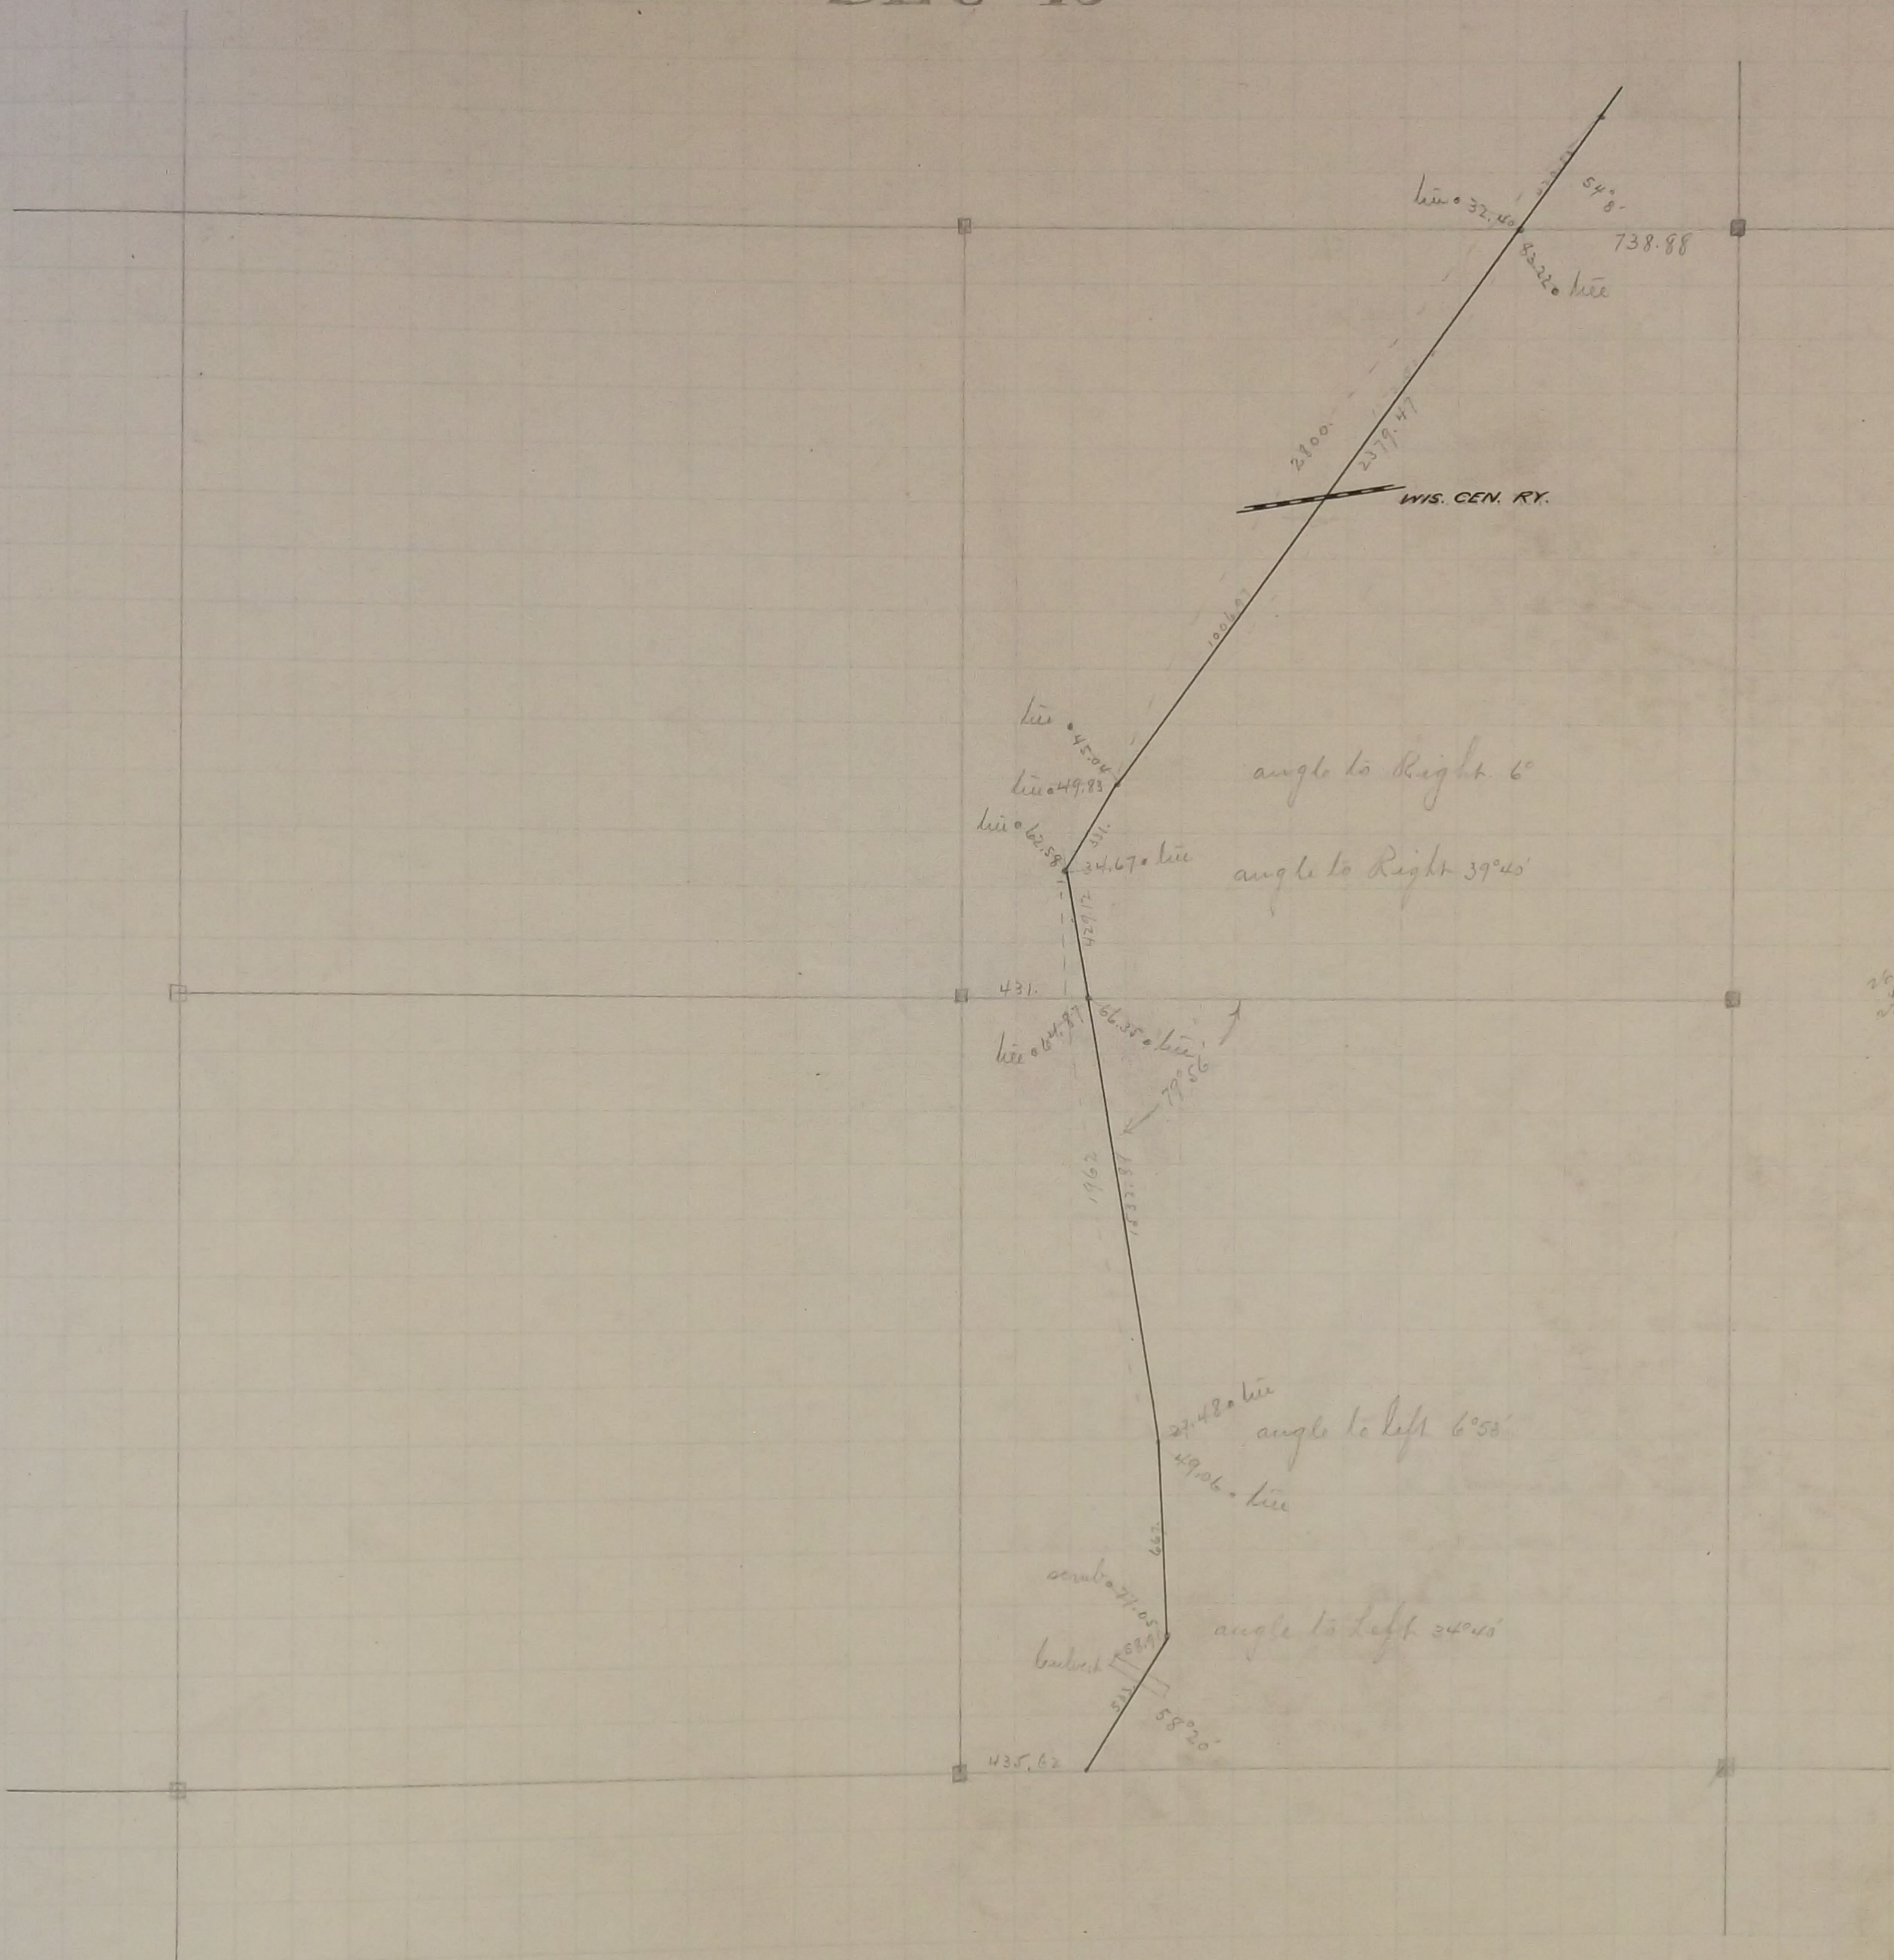

26
 43
 22

The South East corner of Section 15 Fixed by City Engineer Monument

The South West corner of Section 15 Fixed by City Engineer Monument

The $\frac{1}{4}$ corner between Sections 15 and 22 Fixed by City Engineer Monument

Made Survey of White Bear Road through Section 15 in July - 1896 see Page 63

The $\frac{1}{4}$ corner between Sections 10 and 15
Fixed from some old notes Government trees gone Set Monument June 1896

The North East corner of Section 15
Found Government witness stump 1896 Set Monument

The $\frac{1}{4}$ corner between Sections 14 and 15 found old stake Set Monument 1895
Government witness trees gone

The $\frac{1}{4}$ corner between Sections 15 and 16 Government trees gone Monument 1896
Found Iron Monument at corner

The centre of Section 15 was fixed by Intersection Set monument 1896