


SEC 20

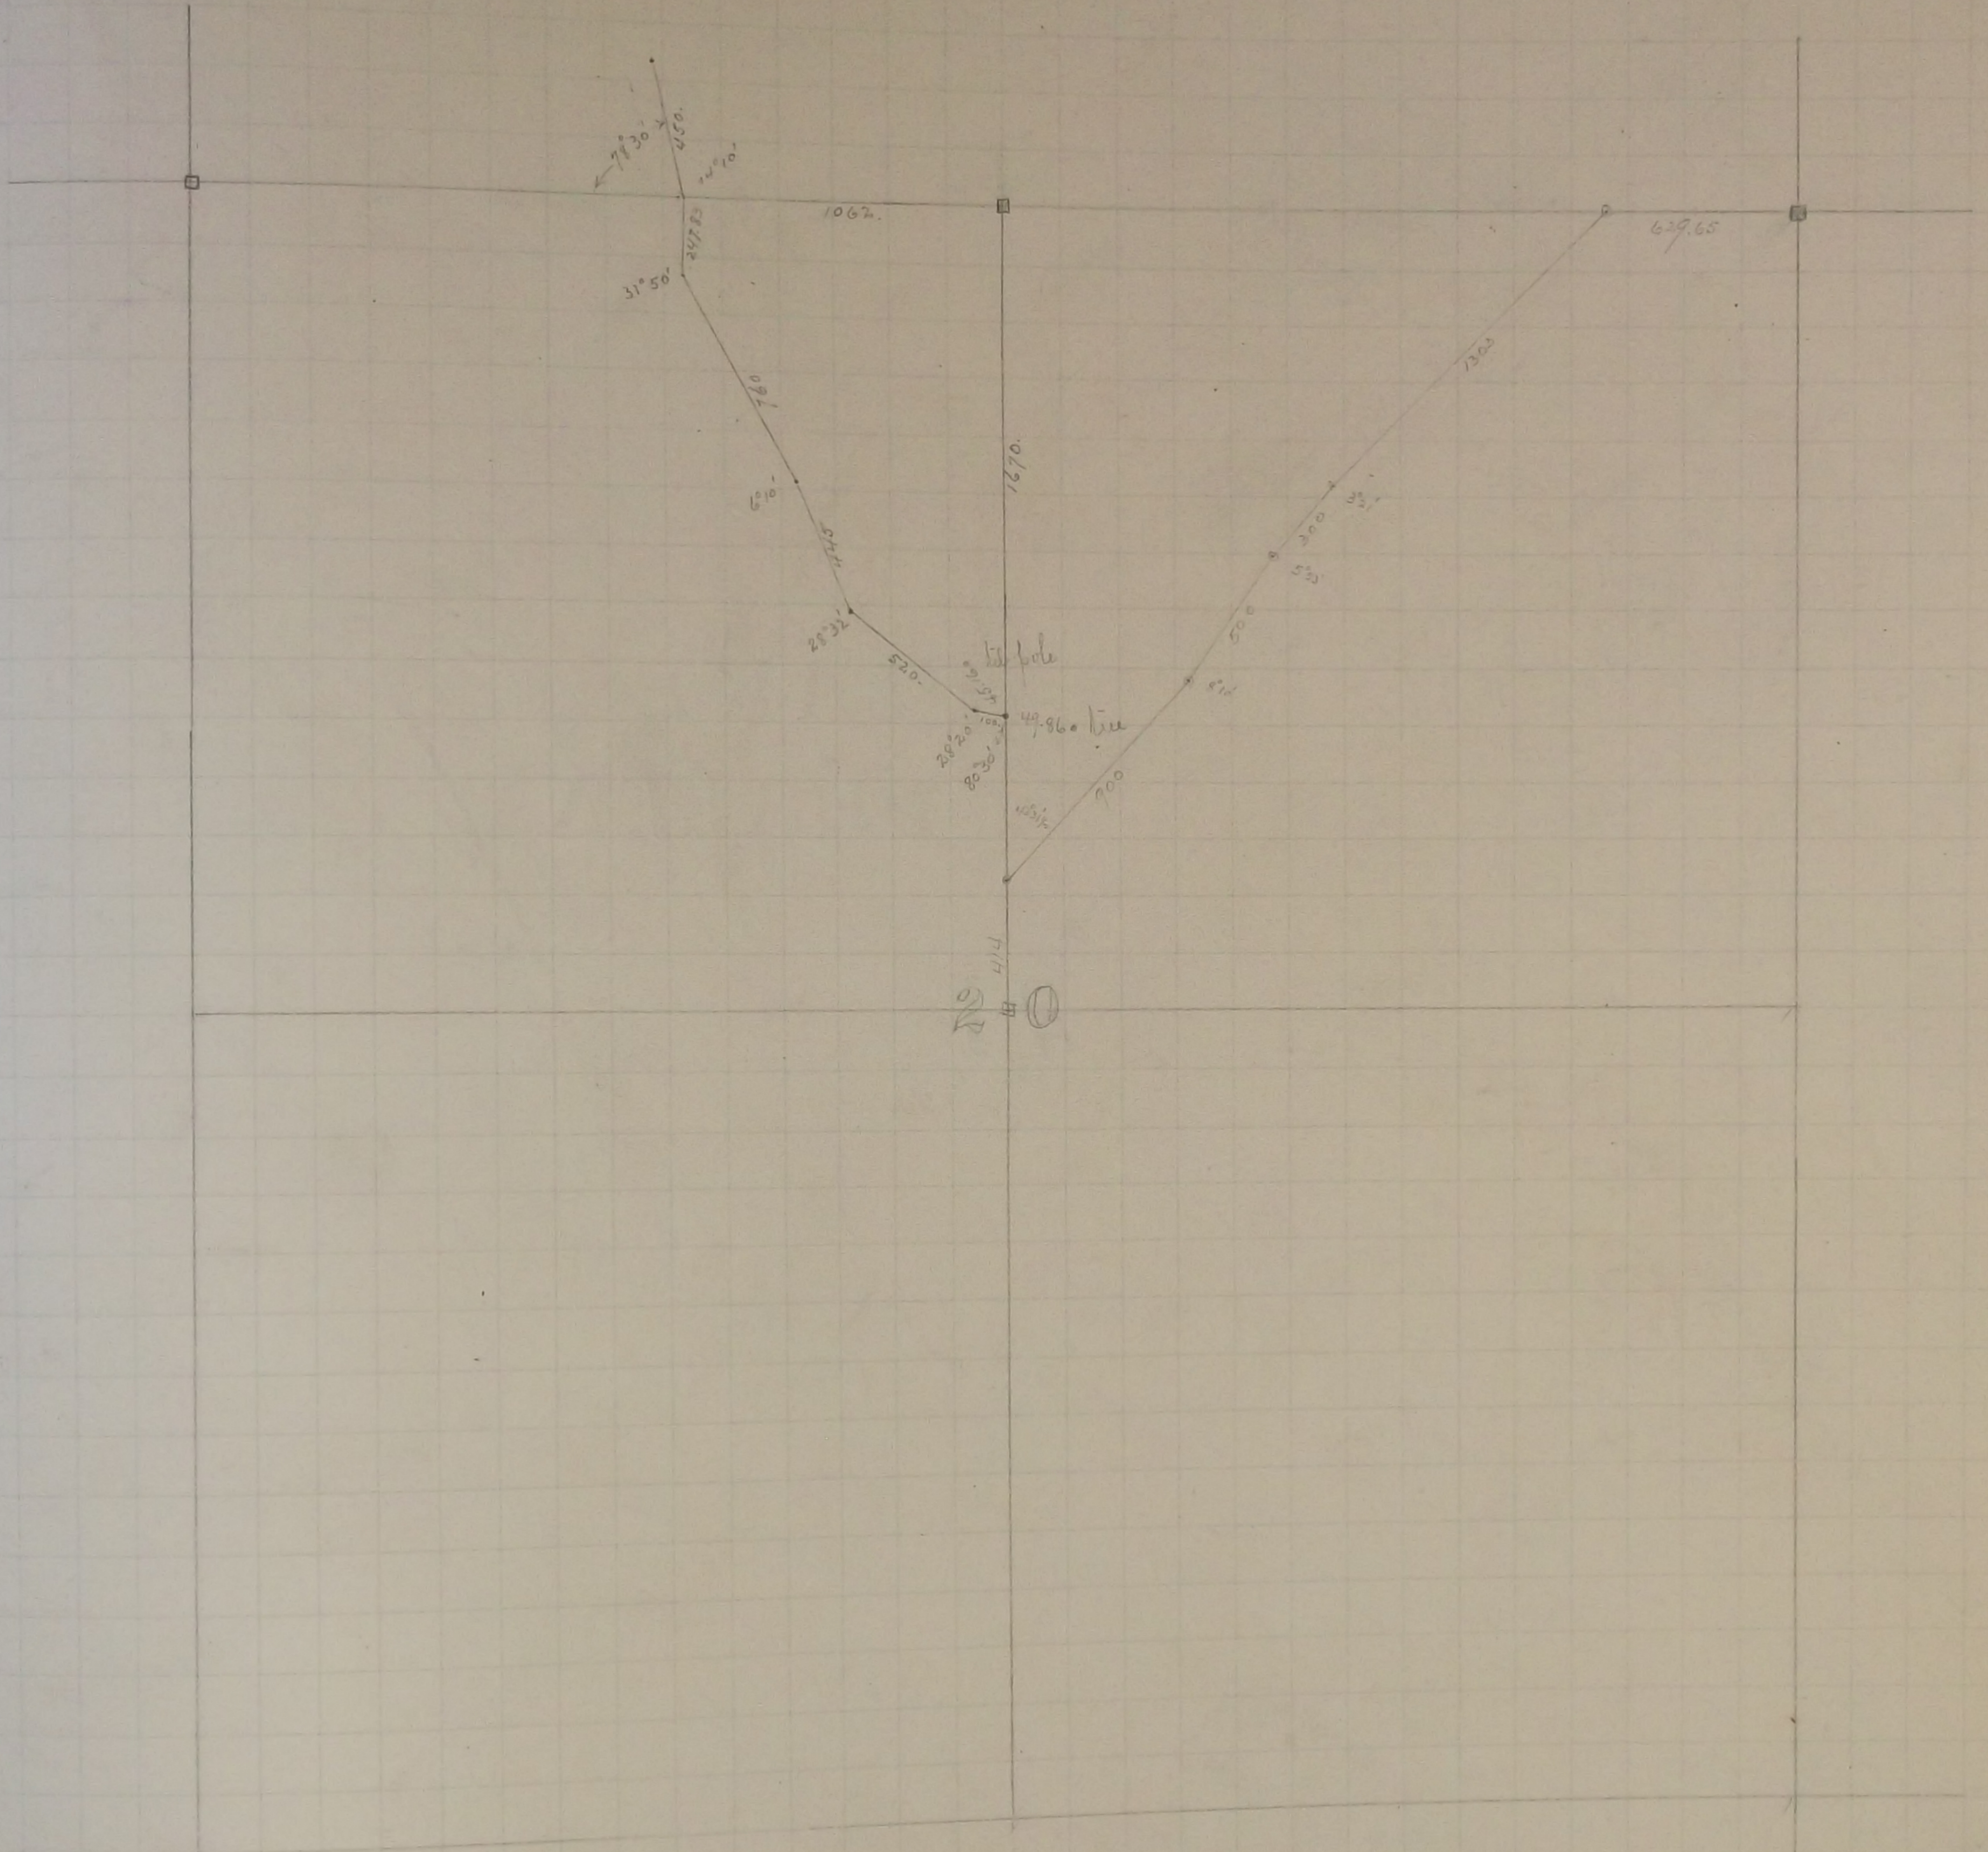

Made Survey of Road in Section 20 in December 10 - 1896